


Map No. _____ Sec. 35 Twp. 27 R. 4
 Well No. 4 Starkey Farm _____
Empire Company _____

NORTH

WEST

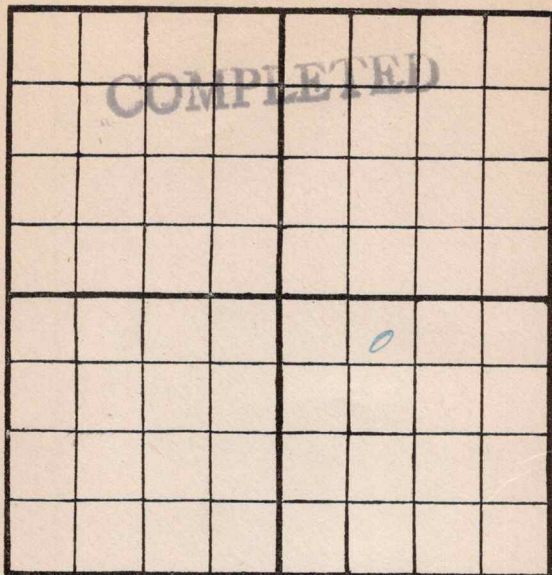

EAST

SOUTH

Location _____

Drilling Remarks:

RECORD

Cased _____ in. _____ ft.
 Sand _____
 Gas _____
 Oil _____
 Total Depth _____

Rig Up _____

Drilling Remarks:

PRODUCTION

1st 24 hrs. Nat. _____
 1st 24 h's. after shot _____
 Gas _____ cu. ft
 Dry Hole _____
 Abandoned _____

Form 26—1M Books of 100 Sheets Each.


Map No. _____ Sec. 35 Twp. 22 R. 4

Well No. 4 Starkey Farm _____

Empire Company _____

NORTH

WEST

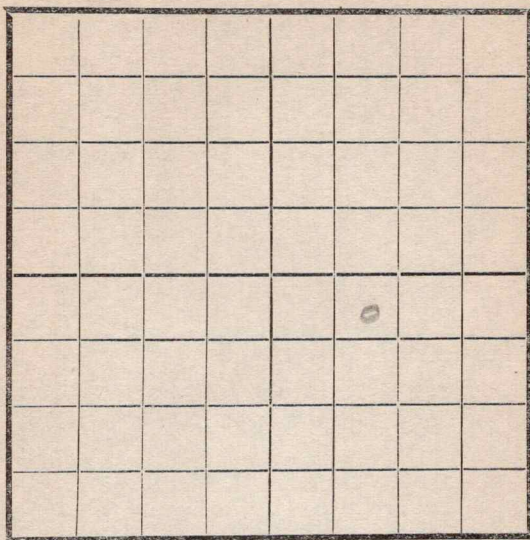

EAST

SOUTH

RECORD

Location _____

Cased _____ in. _____ Ft.

Rig Up _____

Sand _____

Drilling and remarks

Gas _____

Oil _____

Total Depth _____

PRODUCTION

1st 24 hrs. Nat. _____

1st 24 hrs. after shot _____

Gas _____ Cu. Ft.

Dry Hole _____

Abandoned _____

Date


10/9, 1917 Empire Scout _____

Map No. _____ Sec. 35 Twp. 27 R. 4
 Well No. 4 Storker Farm _____
Engine Company _____

NORTH

WEST

EAST

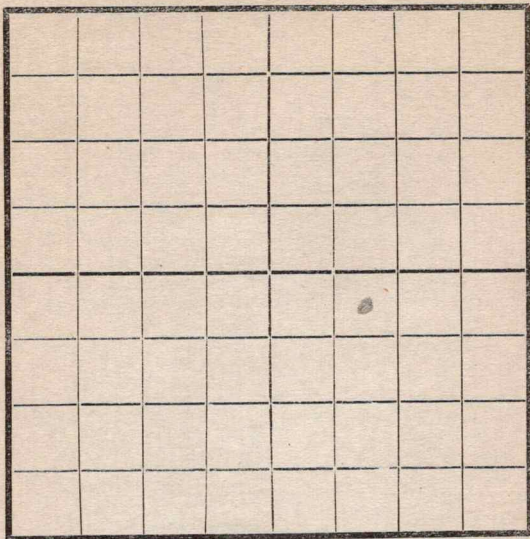

SOUTH

Location _____
 Rig Up _____
 Drilling and remarks

1405

RECORD

Cased _____ in _____ Ft.
 Sand _____
 Gas _____
 Oil _____
 Total Depth _____

PRODUCTION

1st 24 hrs. Nat. _____
 1st 24 hrs. after shot _____
 Gas _____ Cu. Ft.
 Dry Hole _____
 Abandoned _____


Date

10/7, 1917 Carly Scout

Map No. _____ Sec. 35 Twp. 37 R. 4Well No. 4 Starkey Farm __________Engineer Company _____

NORTH

WEST

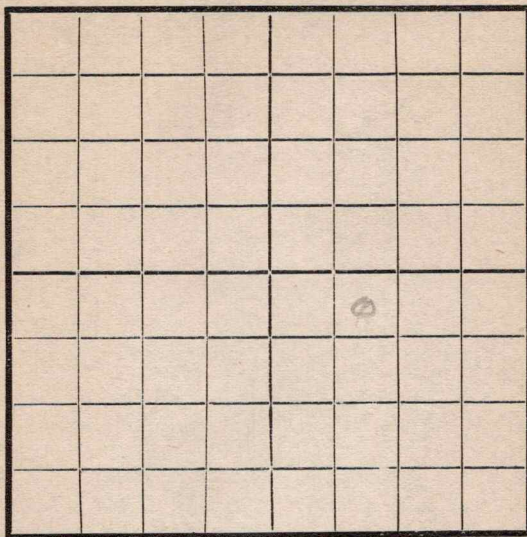

EAST

SOUTH

Location _____

Rig Up _____

Drilling and remarks

RECORD

Cased _____ in. _____ Ft.

Sand _____

Gas _____

Oil _____

Total Depth _____

PRODUCTION

1st 24 hrs. Nat. _____

1st 24 hrs. after shot _____

Gas _____ Cu. Ft.

Dry Hole _____

Abandoned _____


Date

1/24, 1917 Carly Scout

Map No. _____ Sec. 35 Twp. 27 R. 4
 Well No. 4 Starkey Farm _____
Campbell Company _____

NORTH

WEST

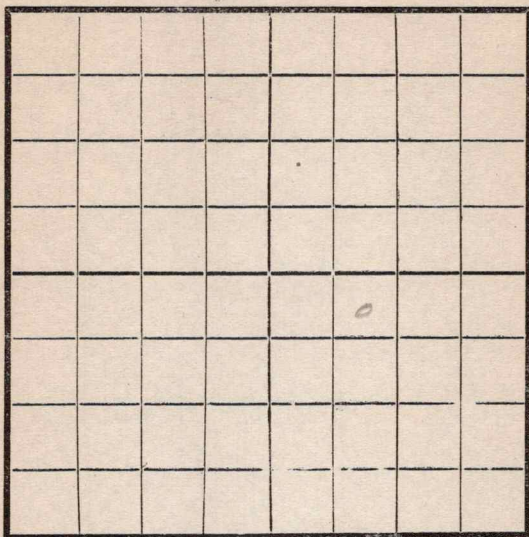

EAST

SOUTH

Location _____
 Rig Up _____
 Drilling and remarks

1840

RECORD

Cased _____ in _____ Ft.
 Sand _____
 Gas _____
 Oil _____
 Total Depth _____

PRODUCTION

1st 24 hrs. Nat. _____
 1st 24 hrs. after shot _____
 Gas _____ Cu. Ft.
 Dry Hole _____
 Abandoned _____

Date


10/31, 1917 Campbell Scout

Map No. _____ Sec. 35 Twp. 27 R. 4Well No. 4 Starker Farm _____

Company _____

NORTH

WEST

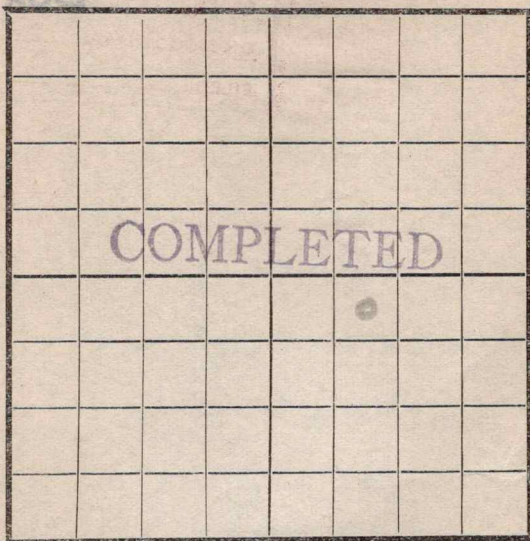

EAST

SOUTH

Location _____

Rig Up _____

Drilling and remarks

RECORD

Cased _____ in. _____ Ft.

Sand 2038-2105

Gas _____

Oil _____

Total Depth _____

PRODUCTION

1st 24 hrs. Nat. _____

1st 24 hrs. after shot _____

Gas _____ Cu. Ft.

Dry Hole _____

Abandoned _____

Date

11-2, 1912 Conduff Scout