


Map No. Kansas Sec. 35 Twp. 27 R. 4

Well No. 10 Starkey Farm

Linclair & Empire Company

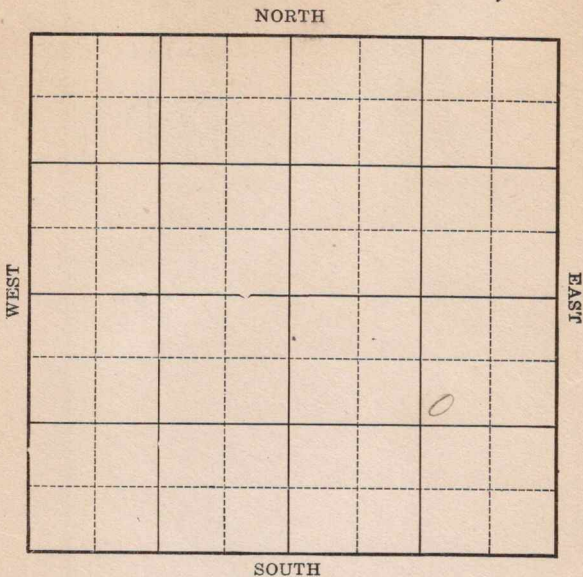

Location _____

Drilling Remarks _____

Rig Up _____

Drilling Remarks _____

RECORD

Cased _____ in. _____ ft.

Sand _____

Gas _____

Oil _____

Total Depth _____

PRODUCTION

1st 24 hrs. Nat. _____

1st 24 hrs. after shot _____


Gas _____ cu. ft.

Dry Hole _____

Abandoned _____

Map No. Kansas Sec. 35 Twp. 27 R. 4
 Well No. 10 Starkey Farm
Shelclair & Empire Company

NORTH

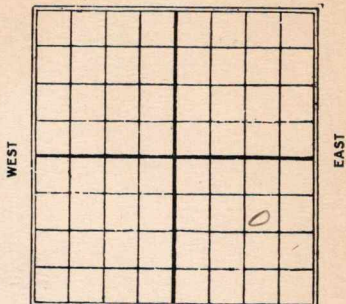

SOUTH

990 Ft. from N. Line

_____ Ft. from S. Line

990 Ft. from E. Line

_____ Ft. from W. Line

Date

REPORT

1926	
5/26	Rig up
6/2	
6/10	Spudding
6/18	Dlg 420
6/25	" 1510
6-30	" 1940
7/8	running 6" - 2525
7/15	sand 2517-28 shale 2528
	-46' sand 2546-53
	2400' oil in hole - C.O.
7/21	sand 2517-53, T.D. 2553
	Shale bkt. 2528-46
	165 bbls. Natural

K11 **KANSAS** *Butler*
 Map No. _____ Sec. *35* Twp. *27* R. *4*
 Well No. *10 Starkey*
Snclair & Empire Company

Contractor

FIRST REPORTS

SECTION PLAT

990 Ft. from N. Line

_____ Ft. from S. Line

990 Ft. from E. Line

_____ Ft. from W. Line

Location _____

Rig up ☒ _____

Drilling and Remarks:

RECORD

Cased _____ in., _____ ft.

Sand _____

Gas _____

Oil _____

Total Depth _____

PRODUCTION

1st 24 hrs. Nat. _____

1st 24 hrs. after shot _____

Gas _____ Cu. Ft.

Dry Hole _____

Abandoned _____

Date

MAY 26 1926

192

CHAS. L. SHERWOOD

Scout

K11 KANSAS *Butter*
 Map No. *35* Sec. *27* Twp. *4* R. *4*
 Well No. *10* *Harley*
Dunclain & Empire Company

Contractor

COMPLETED

SECTION PLAT

990 Ft. from N. Line

Ft. from S. Line

990 Ft. from E. Line

Ft. from W. Line

			0

Location

Rig up

Drilling and Remarks:

*Shab Bis 2528-46**165 BS Natural.*

RECORD

Cased *2517* in. *2553* ft.

Sand

Gas

Oil

Total Depth *2553*

PRODUCTION

1st 24 hrs. Nat.

1st 24 hrs. after shot

Gas Cu. Ft.

Dry Hole

Abandoned

Date

JUL 21 1926

CHAS. L. SHERWOOD

192

Scout