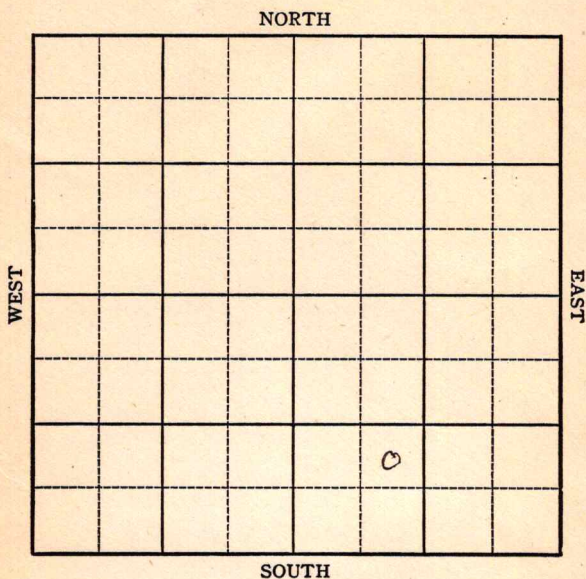


KANSAS

Greenwood county

Section 35 Township 25 Range 10-EWell No. #2, Sample "B"Company Arrow Oil

KANSAS

Greenwood county

Sec. 35 Twp. 25 R. 10-E

Well No. #2, Sample "B" Farm

Arrown Oil Company Company

Miscellaneous


Ft. from N. Line

990' Ft. from S. Line

Ft. from E. Line

990' Ft. from W. Line

NE SW SE

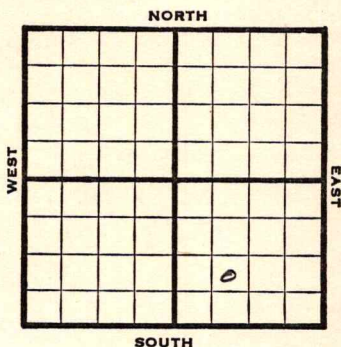

1946	REPORT
10/2	Spud.
10/8	150 SD
10/15	12" @ 500' Drlg 590'
10/22	Drlg 980'
10/29	10 " @ 100' 8" @ 1450 CO
11/6	6" @ 1700' Drlg 1710'
11/12	Miss 1971 Pay 1994' TD 1995' Est 10 oil a day & ran 5"
11/20	SD
11/27	"
12/3	TD 2000' 5" @ 1971'
12/10	"
12/17	TD 2006-2000' acid Wtr.
1947	
1/4	TD 2006', 2000 acid, wtr.
1/8	Miss 1971' TD 2006'
	ABANDONED

KANSASKansas Pool Name MiscellaneousMap No. 16 Sec. 35 Twp. 25 R. 10EWell No. 2 Sample "B"Arrow Oil

Company

FIRST REPORT

Contractor

NE SW SE

SECTION PLAT

		0	

 Ft. from N. Line990 Ft. from S. Line Ft. from E. Line990 Ft. from W. LineGreenwood CountyLocation Rig up

Drilling and Remarks:

Spud

RECORDCased in., ft.Sand Gas Oil Total Depth **PRODUCTION**1st 24 hrs. Nat. 1st 24 hrs. after shot Gas Cu. Ft.Dry Hole Abandoned

Date

OCT 2 1946 19S. J. LEWIS

Scout

Map No. 16 Sec. 35 Twp. 25 R. 10E

Well No. 2 Sample "B"

Arrow Oil

Company

ABANDONED

Contractor

NE SW SE

SECTION PLAT

 Ft. from N. Line

990 Ft. from S. Line

 Ft. from E. Line

990 Ft. from W. Line

Greenwood County

RECORD

Location

Cased in., ft.

Rig up

Sand

Drilling and Remarks:

Gas

Oil

Total Depth 2006

Miss 1971

PRODUCTION

1st 24 hrs. Nat.

1st 24 hrs. after shot

Gas Cu. Ft.

Dry Hole

Abandoned

Date

JAN 8 1947 19 S. J. LEWIS Scout