


KANSAS

Greenwood

Section 35 Township 25 Range 10-E

Well No. #7 Sample

Company Arrow Drlg
Miscellaneous

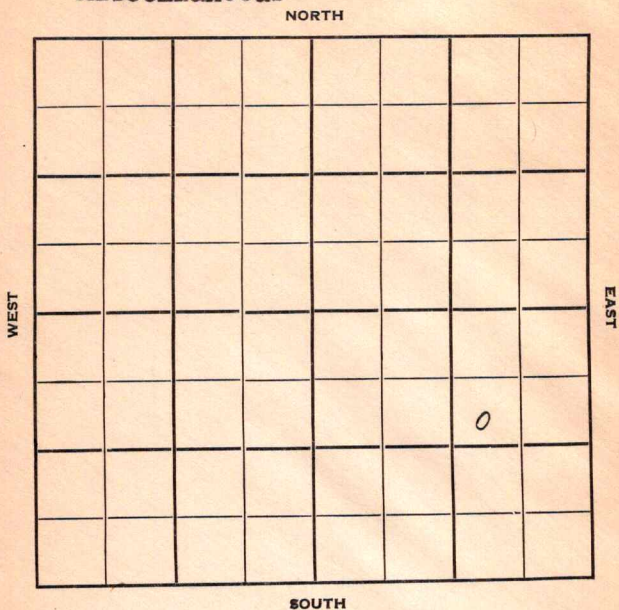

Greenwood

KANSAS

Sec. 35 Twp. 25 R. 10E

Well No. #7 Sample Farm

Arrow Drlg. Company

Contractor

Miscellaneous


990' Ft. from N. Line

Ft. from S. Line

990' Ft. from E. Line

Ft. from W. Line

SW NE SE

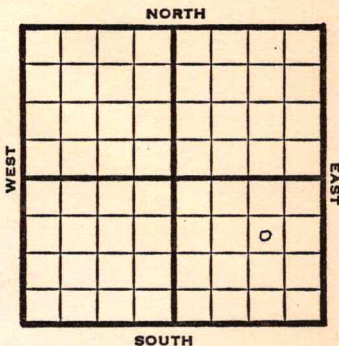

1950

REPORT

3/8

Spud 2-27-50

8" @ 30

4/5

TD 1990'

8" @ 30'

6 5/8" @ 100

Miss 1970'

4 1/2" @ 1981'

50 BO PD

Comp

COMPLETED

Map No. _____ Sec. 35 Twp. 25 R. 10EWell No. 7 Sample _____

_____ Arrow Drlg. _____ Company

_____ Contractor

SW NE SE

SECTION PLAT

990 Ft. from N. Line

_____ Ft. from S. Line

990 Ft. from E. Line

_____ Ft. from W. Line

Greenwood County

Location _____

Rig up _____

Drilling and Remarks:

Spud 2-27-50

8" @ 30

RECORD

Cased _____ in., _____ ft.

Sand _____

Gas _____

Oil _____

Total Depth _____

PRODUCTION

1st 24 hrs. Nat. _____

1st 24 hrs. after shot _____

Gas _____ Cu. Ft.

Dry Hole _____

Abandoned _____

Date

MAR 8 1950

19

J. E. TYRA

Scout

Kansas

Miscellaneous

Map No. _____ Sec. 35 Twp. 25 R. 10EWell No. 7 Sample


Arrow Drlg.

Company

Contractor

SW NE SE

SECTION PLAT

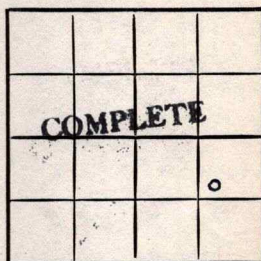990 Ft. from N. Line

Ft. from S. Line

990 Ft. from E. Line

Ft. from W. Line

Greenwood County

RECORD

Location _____

Cased _____ in., _____ ft.

Rig up _____

Sand _____

Drilling and Remarks:

Gas _____

Oil _____

Total Depth 1990

PRODUCTION

1st 24 hrs. Nat. _____

1st 24 hrs. after shot _____

Gas _____ Cu. Ft.

Dry Hole _____

Abandoned _____

Date

APR 5 1950

19

J. E. TYRA

Scout