

Map No. _____ Sec. 35 Twp. 27 R. 4Well No. 5 Starkey Farm _____
Empire Company

NORTH

WEST

EAST



SOUTH

Location _____

Rig Up _____

Drilling Remarks:

Drilling Remarks:

RECORD

Cased _____ in. _____ ft.

Sand _____

Gas _____

Oil _____

Total Depth _____

PRODUCTION

1st 24 hrs. Nat. _____

1st 24 hrs. after shot _____

Gas _____ cu. ft

Dry Hole _____

Abandoned _____

Map No. H11 Sec. 35 Twp. 27 R. 4
 Well No. 5 Starkey Farm
Empire Company

NORTH

WEST

EAST

SOUTH

Location -----

Rig up -----

Drilling and remarks:

1

FIRST REPORT

RECORD

Cased ----- in. ----- Ft.

Sand -----

Gas -----

Oil -----

Total Depth -----

PRODUCTION

1st 24 hrs. Nat. -----

1st 24 hrs. after shot -----

Gas ----- Cu. Ft.

Dry Hole -----

Abandoned -----

Date

4/3, 1918, Empire Scout

Map No. _____ Sec. 35 Twp. 27 R. 4

Well No. 5 Starkey


_____ Company

_____ Contractor

NORTH

WEST

EAST

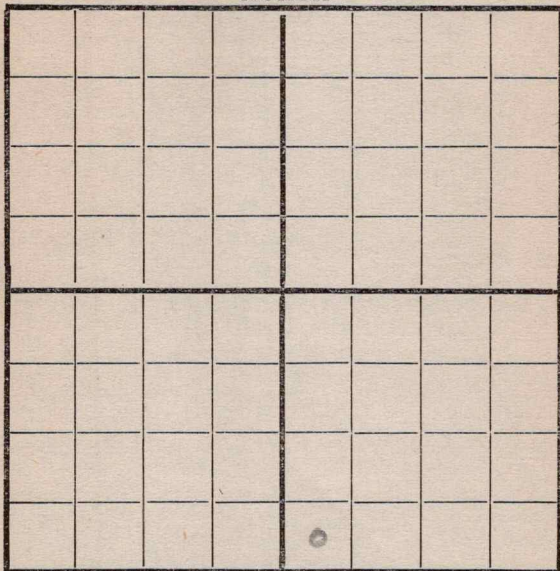

SOUTH

Location _____

Rig up ☒ _____

Drilling and Remarks:

RECORD

Cased _____ in., _____ ft.

Sand _____

Gas _____

Oil _____

Total Depth _____

PRODUCTION

1st 24 hrs. Nat. _____

1st 24 hrs. after shot _____

Gas _____ Cu. Ft.

Dry Hole _____

Abandoned _____

Date

6/26 1918, Condry Scout

Map No. _____ Sec. 35 Twp. 27 R. 4

Well No. 50


Engine Company

Contractor

NORTH

WEST

EAST

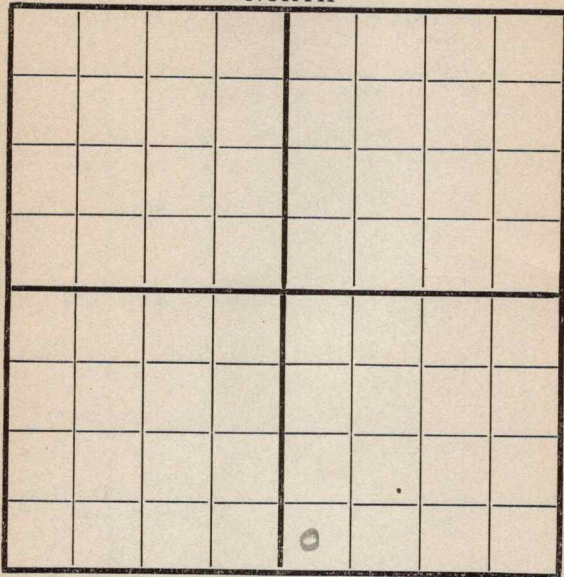

SOUTH

Location ✓

Rig up _____

Drilling and Remarks:

RECORD

Cased _____ in., _____ ft.

Sand _____

Gas _____

Oil _____

Total Depth _____

PRODUCTION

1st 24 hrs. Nat. _____

1st 24 hrs. after shot _____

Gas _____ Cu. Ft.

Dry Hole _____

Abandoned _____

Date

7/3 191 P. C. C. C. Scout

Map No. _____ Sec. 35 Twp. 27 R. 4Well No. 5 Star KeyCamping CompanyRichardson Drill Co ContractorAugust NORTH Ks

WEST								EAST
SOUTH								

RECORD

Location _____

Cased _____ in., _____ ft.

Rig up _____

Sand _____

Drilling and Remarks:

Gas _____

Oil _____

Total Depth _____

PRODUCTION

1st 24 hrs. Nat. _____

1st 24 hrs. after shot _____

Gas _____ Cu. Ft.

Dry Hole _____

Abandoned _____

Date

7/10 191 8 C. Conley Scout

Map No. _____ Sec. 35 Twp. 27 R. 4Well No. 5000

_____ Company

_____ Contractor

NORTH

WEST

EAST

SOUTH

Location _____

Rig up _____

Drilling and Remarks:

800

RECORD

Cased _____ in., _____ ft.

Sand _____

Gas _____

Oil _____

Total Depth _____

PRODUCTION

1st 24 hrs. Nat. _____

1st 24 hrs. after shot _____

Gas _____ Cu. Ft.

Dry Hole _____

Abandoned _____

Date

7/17

191

8Conley


Scout

Map No. _____ Sec. 35 Twp. 27 R. 4Well No. 5 StarkeyEngine _____ Company __________
Contractor _____

NORTH

WEST

EAST

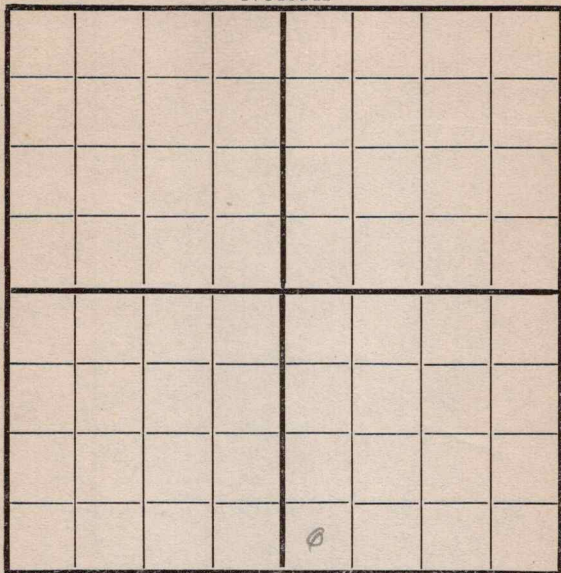

SOUTH

Location _____

Rig up _____

Drilling and Remarks:

1300

RECORD

Cased _____ in., _____ ft.

Sand _____

Gas _____

Oil _____

Total Depth _____

PRODUCTION

1st 24 hrs. Nat. _____

1st 24 hrs. after shot _____

Gas _____ Cu. Ft.

Dry Hole _____

Abandoned _____

Date

7/24 1918 8 Conley Scout


Map No. _____ Sec. 35 Twp. 27 R. 4Well No. 5 StarkeyEmpire Dr. F Company _____

Contractor _____

NORTH

WEST

EAST

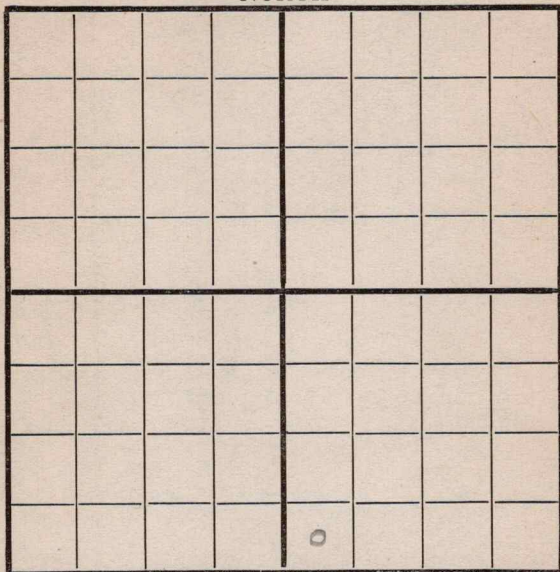

SOUTH

330 ~~107~~ SL X 330 ~~107~~ 10. Line

Location _____

Rig up _____

Drilling and Remarks:

1900

RECORD

Cased _____ in., _____ ft.

Sand _____

Gas _____

Oil _____

Total Depth _____

PRODUCTION

1st 24 hrs. Nat. _____

1st 24 hrs. after shot _____

Gas _____ Cu. Ft.

Dry Hole _____

Abandoned _____

Date

7/311918Candy

Scout _____

Map No. _____ Sec. 35 Twp. 27 R. 4Well No. 7 Moyle


Company _____

Contractor _____

NORTH

WEST

EAST

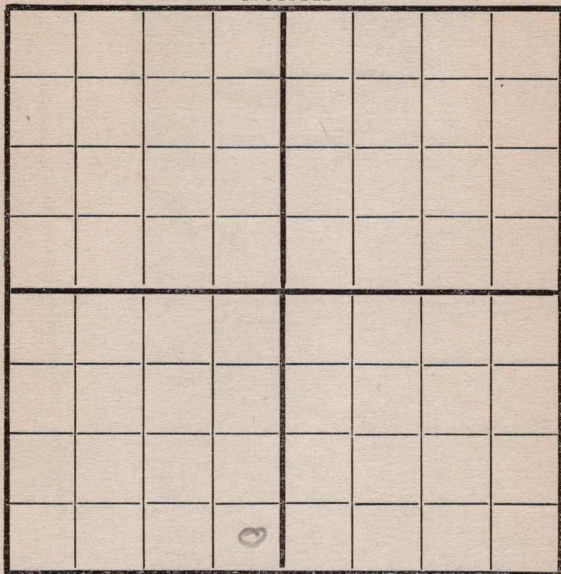

SOUTH

RECORD

Location _____

Cased _____ in., _____ ft.

Rig up _____

Sand _____

Drilling and Remarks:

Gas _____

Oil _____

Total Depth _____

PRODUCTION

1st 24 hrs. Nat. _____

1st 24 hrs. after shot _____

Gas _____ Cu. Ft.

Dry Hole _____

Abandoned _____

Date

8/7


191

J. C. Condy

Scout

1001 K11
Map No. K11 Sec. 35 Twp. 27 R. 4Well No. 5 starkeyEmpire B. 7 CompanyRichardson Drilling ContractorAugusta NORTH K

WEST

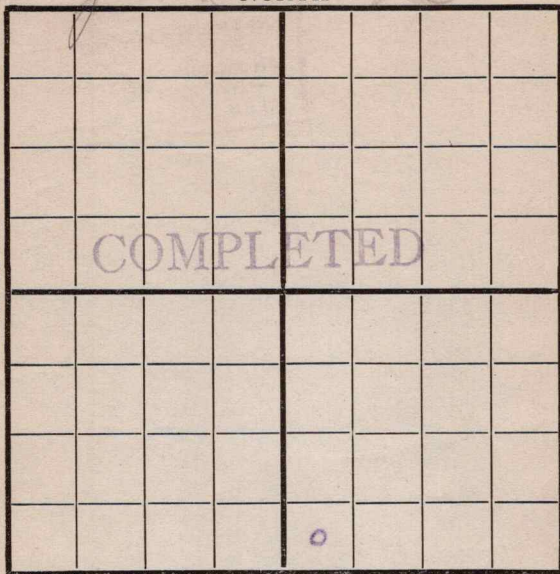

EAST

SOUTH

RECORD

Location _____

Cased _____ in., _____ ft.

Rig up _____

Sand 2061-2075

Drilling and Remarks:

Gas _____

Oil _____

Total Depth _____

Estimated
at 200
Bbls

PRODUCTION

1st 24 hrs. Nat. _____

1st 24 hrs. after shot _____

Gas _____ Cu. Ft.

Dry Hole _____

Abandoned _____

Date

8/7 191 8 Candy Scout