


KANSAS

Greenwood

Section 35 Township 25 Range 10-EWell No. #6 SampleCompany Arrow Oil
Miscellaneous

NORTH

WEST

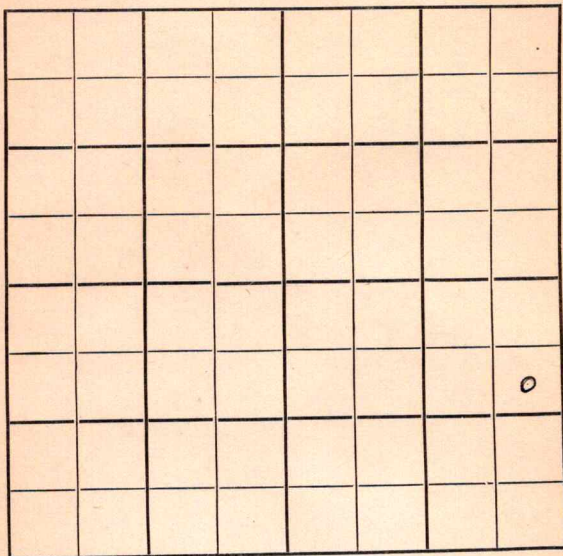

EAST

SOUTH

Sec. 35 Twp. 25 R. 10E ✓

Well No. #6 Sample Farm
Arrow Oil Company

Contractor

Miscellaneous


990' Ft. from N. Line

 Ft. from S. Line

330' Ft. from E. Line

 Ft. from W. Line

SE NE SE

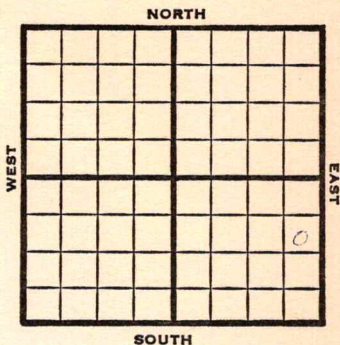

1950

REPORT

3/1 Spud 2-27-50
7" @ 112'
Drlg. 450'
3/15 TD 1980'
7"@ 112'
5"@ 1977'
Miss 1968'
15 BOPD
Comp

COMPLETED

Map No. _____ Sec. 35 Twp. 25 R. 10EWell No. 6 SampleArrow Oil

Company _____

Contractor _____

SE NE SE

SECTION PLAT

990 Ft. from N. Line

_____ Ft. from S. Line

330 Ft. from E. Line

_____ Ft. from W. Line

Greenwood County

RECORD

Location _____

Cased _____ in., _____ ft.

Rig up _____

Sand _____

Drilling and Remarks:

Gas _____

Oil _____

Total Depth _____

Spud 2-27-507" @ 112drlg. 450

PRODUCTION

1st 24 hrs. Nat. _____

1st 24 hrs. after shot _____

Gas _____ Cu. Ft.

Dry Hole _____

Abandoned _____

Date

J. E. TYRAMAR 1 1950 19

Scout

Map No. _____ Sec. 35 Twp. 25 R. 10E

Well No. 6 Sample

Arrow Drlg. Company

Contractor

SE NE SE

SECTION PLAT

990 Ft. from N. Line

_____ Ft. from S. Line

330 Ft. from E. Line

_____ Ft. from W. Line

		COMPLETE	
			o

Greenwood County

Location _____

Rig up _____

Drilling and Remarks:

7' @ 112

5" @ 1977

miss 1968

15 BOPD

RECORD

Cased _____ in., _____ ft.

Sand _____

Gas _____

Oil _____

Total Depth 1980

PRODUCTION

1st 24 hrs. Nat. _____

1st 24 hrs. after shot _____

Gas _____ Cu. Ft.

Dry Hole _____

Abandoned _____

Date

MAR 15 1950

19

J. E. TYRA Scout