


Map No. *17N* Sec. *35* Twp. *27* R. *4*Well No. *11 Starkey* Farm*Sinclair & Empire* Company

NORTH

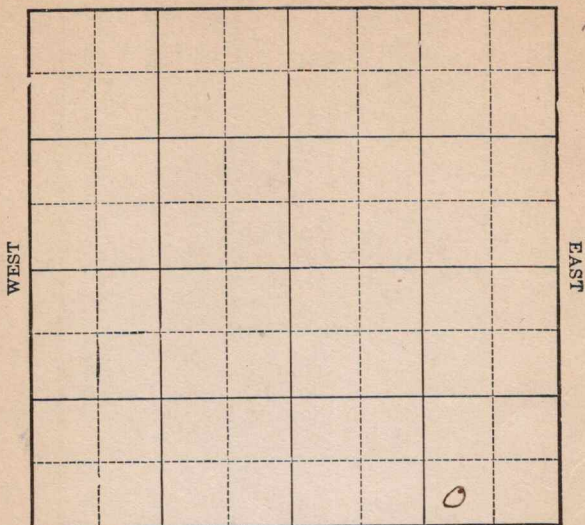

SOUTH

Location _____

Drilling Remarks _____

Rig Up _____

Drilling Remarks _____

RECORD

Cased _____ in. _____ ft.

Sand _____

Gas _____

Oil _____

Total Depth _____

PRODUCTION

1st 24 hrs. Nat. _____

1st 24 hrs. after shot _____

Gas _____ cu. ft.


Dry Hole _____

Abandoned _____

Butler

Map No. 127 Sec. 35 Twp. 27 R. 4Well No. 11 Starkey FarmSinclair & Empire Company

NORTH

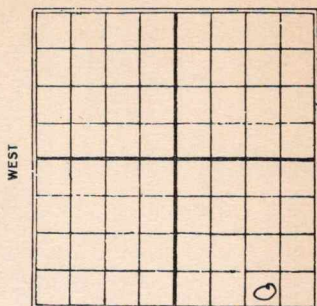

Ft. from N. Line

330 Ft. from S. Line990 Ft. from E. Line

Ft. from W. Line

1926

Date

REPORT

8/4 Location

8/11 Drilling up

8/18 Dlg 360

8/25 " 910

8-31 " 1850

9/15 Sand 2540-79'

pay 64 to 74'

swabbed 80 bbls

will shoot

9/22 Sand 2540-2579

Pay 2564-74

80 bbls nat.

11 **KANSAS** Sec 35 Twp. 27 R. 4

Well No. 11 Starkey
Finclair & Empire Company

Contractor

FIRST REPORTS

SECTION PLAT

_____ Ft. from N. Line

330 _____ Ft. from S. Line

990 _____ Ft. from E. Line

_____ Ft. from W. Line

			0

Location _____

Rig up _____

Drilling and Remarks:

RECORD

Cased _____ in., _____ ft.

Sand _____

Gas _____

Oil _____

Total Depth _____

PRODUCTION

1st 24 hrs. Nat. _____

1st 24 hrs. after shot _____

Gas _____ Cu. Ft.

Dry Hole _____

Abandoned _____

Date

AUG 4 1926

CHAS. L. SHERWOOD

192

Scout

11 **KANSAS** *Butler*
 Map No. _____ Sec. *35* Twp. *27* R. *4*
 Well No. *11* *Harkey*
Anchor & Empire _____ Company

_____ Contractor

COMPLETED

SECTION PLAT

_____ Ft. from N. Line

330 _____ Ft. from S. Line

990 _____ Ft. from E. Line

_____ Ft. from W. Line

			o

Location _____

Rig up _____

Drilling and Remarks:

Day 2564-74'

80 lbs natural

RECORD

Cased _____ in., _____ ft.

Sand *2540-2579*

Gas _____

Oil _____

Total Depth *2579*

PRODUCTION

1st 24 hrs. Nat. _____

1st 24 hrs. after shot _____

Gas _____ Cu. Ft.

Dry Hole _____

Abandoned _____

Date

SEP 22 1926

CHAS. L. SHERWOOD

192

Scout