

NORTH

9

PRODUCTION

1st 24 hrs. Nat. _____

1st 24 hrs. after shot _____

Gas _____ cu. ft.


Dry Hole _____

Abandoned _____

Butler

Map No. MAN Sec. 35 Twp. 27 R. 4Well No. 12 Starkey FarmSinclair & Empire Company

NORTH

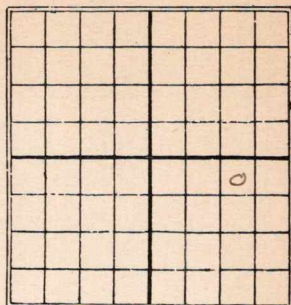230 Ft. from N. Line

Ft. from S. Line

990 Ft. from E. Line

Ft. from W. Line

1926

Date

REPORT

8/25 Rig up.

8-31 Spudg

9/15 Drilg 1210

9/22 " 1530

9/29 " 1965

10/3 Sand 2525-60

P.B. to 2558 - 110 bbls
natural

11 **KANSAS** *Butler*
 Map No. _____ Sec. *35* Twp. *27* R. *4*

Well No. *12 Stanley*
Shelton & Empire _____ Company

 Contractor

FIRST REPORTS

SECTION PLAT

330 _____ Ft. from N. Line

_____ Ft. from S. Line

990 _____ Ft. from E. Line

_____ Ft. from W. Line

			0

Location _____

Rig up ☒ _____

Drilling and Remarks:

RECORD

Cased _____ in., _____ ft.

Sand _____

Gas _____

Oil _____

Total Depth _____

PRODUCTION

1st 24 hrs. Nat. _____

1st 24 hrs. after shot _____

Gas _____ Cu. Ft.

Dry Hole _____

Abandoned _____

Date

AUG 25 1926

CHAS. L. SHERWOOD

192

Scout


Butler

11 KANSAS 35 27 R. 4
 Map No. Sec. Twp.
 Well No. 12 Stankey
 Anchor & Condit
 Farm
 Company

NORTH

WEST

EAST

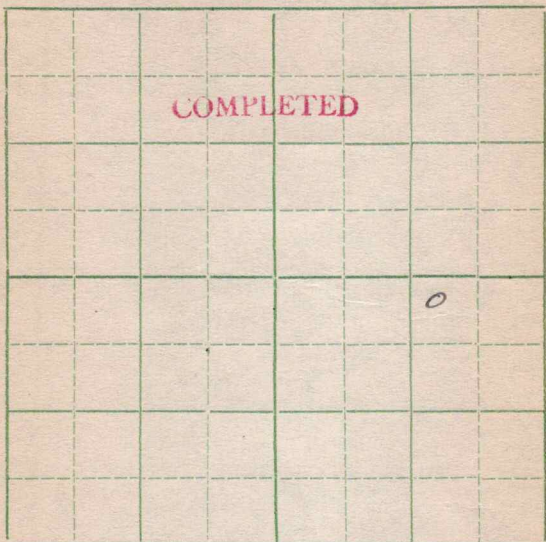

SOUTH

Location _____

Rig up _____

Drilling and Remarks:

Plugged back to 2558'

110 BS natural

RECORD

Cased _____ in., _____ ft.

Sand 2525-60

Gas _____

Oil _____

Total Depth 2560'

PRODUCTION

1st 24 hrs. Nat. _____

1st 24 hrs. after shot _____

Gas _____ Cu. Ft.

Dry Hole _____

Abandoned _____

Date

OCT 13 1926

CHAS. L. SHERWOOD

192

Scout