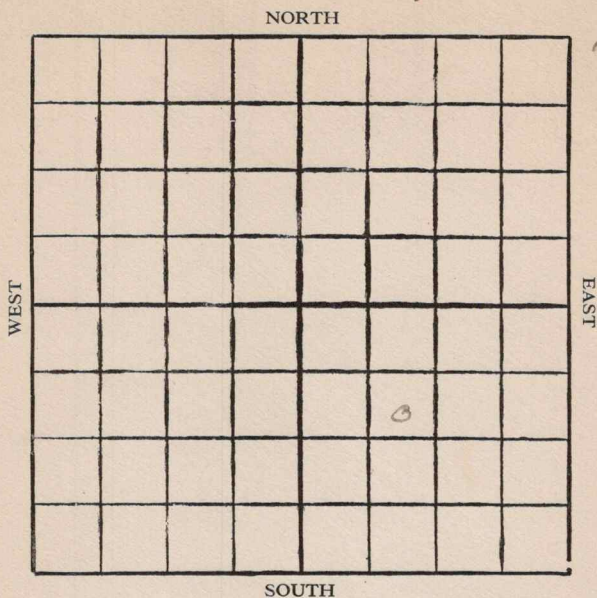


Map No. KS Sec. 35 Twp. 27 R. 4EWell No. 14 - Starkey Farm
Sinclair & Empire Company

Location

Drilling Remarks

Rig Up

Drilling Remarks

RECORD

Cased in. ft.

Sand

Gas

Oil

Total Depth

PRODUCTION

1st 24 hrs. Nat.

1st 24 hrs. after shot

Gas cu. ft.

Dry Hole

Abandoned

Butter

Map No. Kansas Sec. 35 Twp. 27 R. 4^E

Well No. 14 Starkey Farm

Sinclair & Empire Company


NORTH

700 Ft. from N. Line

_____ Ft. from S. Line

_____ Ft. from E. Line

700 Ft. from W. Line

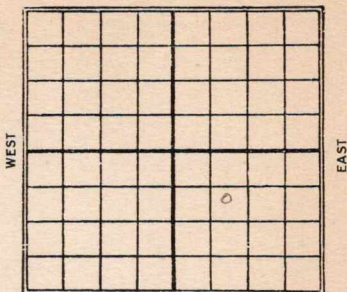

SOUTH

Date

REPORT

1927

1/12 Location

1/19 Rig

1/26 Drlg 375

2/3 " 1285

2/10 " 1730

2/17 " 7200

2/24 NR, 6"-7540

3/2 sand 2528-2532

70 bbls natural

Butler

11 KANSAS

Map No.

Sec.

35

Twp.

27

R.

4^E

Well No.

14

Starkley

Farm

Sinclair & Empire

Company

NORTH

WEST

EAST

		700	from	N.L.		
		700	"	N.L.		
				0		

FIRST REPORTS

SOUTH

Location ✓

Rig up

Drilling and Remarks:

RECORD

Cased _____ in., _____ ft.

Sand _____

Gas _____

Oil _____

Total Depth _____

PRODUCTION

1st 24 hrs. Nat. _____

1st 24 hrs. after shot _____

Gas _____ Cu. Ft.

Dry Hole _____

Abandoned _____

Date

JAN 12 1927

CHAS. L. SHERWOOD

192

Scout

KANSAS


Contractor

COMPLETED

SECTION PLAT

700 Ft. from N. Line

_____ Ft. from S. Line

_____ Ft. from E. Line

700 Ft. from W. Line

		0	

Location _____

Rig up _____

Drilling and Remarks:

70 ss natural

RECORD

Cased _____ in., _____ ft.

Sand 2528-2532

Gas _____

Oil _____

Total Depth 2532

PRODUCTION

1st 24 hrs. Nat. _____

1st 24 hrs. after shot _____

Gas _____ Cu. Ft.

Dry Hole _____

Abandoned _____

Date

MAR 2 1927

192

CHAS. L. SHERWOOD

Scout