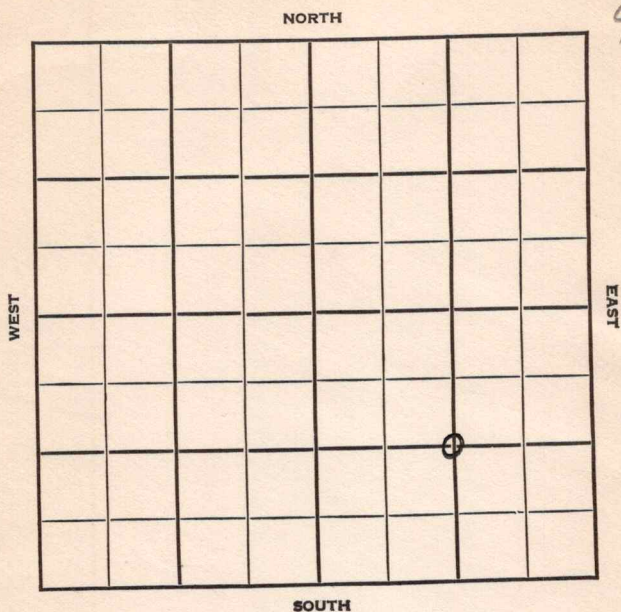


Section 35 Township 27 Range 4-EWell No. #15 StarkeyCompany Sinclair-Prairie & CSO

KANSAS

Butler

Sec. 35 Twp. 27 R. 4EWell No. #15 Starkey Farm

Sinclair-Prairie & CSO

Company

Miscellaneous


1320' Ft. from N. Line

Ft. from S. Line

1320' Ft. from E. Line

Ft. from W. Line

C SE

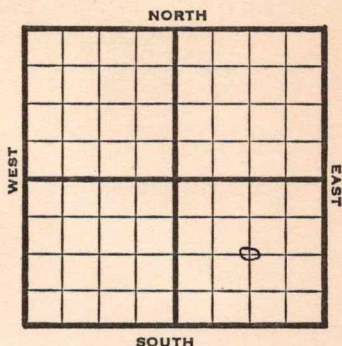

1948

Eli 1306'

REPORT

5/12 Location

5/19 "

5/26 15" @ 100'
Drlg. 725'

6/1 900' SD

6/9 "

6/16 12" @ 725'
10" @ 1222'
Lansing 1650'
Drlg. 1775'

6/23 "

6/29 KC 2240
8"@ 2240
Simpson 2524-
6"@ 2524'
SD

7/8 TD 2568'

7/14 20 qts 2562-67'
CO

7/21 TD 2568'
Simp 2524'
6"@ 2524'
20 qts
Pump 7 Pot
412 Gr.
Comp.

COMPLETED

Map No. _____ Sec. 35 Twp. 27 R. 4EWell No. 15 Starkey_____
Sinclair-Prairie & CSO CompanyFIRST REPORT Contractor _____

C SE


SECTION PLAT

1320 Ft. from N. Line

_____ Ft. from S. Line

1320 Ft. from E. Line

_____ Ft. from W. Line

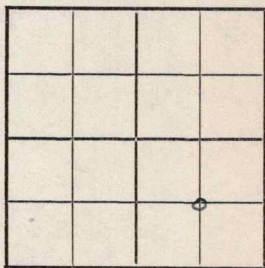Butler CountyLocation X

Rig up _____

Drilling and Remarks:

RECORD

Cased _____ in., _____ ft.

Sand _____

Gas _____

Oil _____

Total Depth _____

PRODUCTION

1st 24 hrs. Nat. _____

1st 24 hrs. after shot _____

Gas _____ Cu. Ft.

Dry Hole _____

Abandoned _____

Date

MAY 12 194819S. J. LEWISScout

Map No. 11 Sec. 35 Twp. 27 R. 4E

Well No. 15 Starkey

Sinclair-Prairie & CSO Company


COMPLETE

Contractor

C SE

E 1.1306

SECTION PLAT

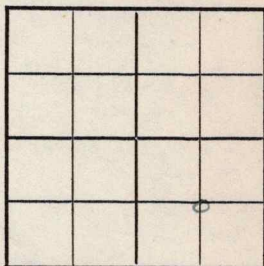

1320 Ft. from N. Line

 Ft. from S. Line

1320 Ft. from E. Line

 Ft. from W. Line

Butler County

Location

Rig up

Drilling and Remarks:

Simple 2524

6" @ 2524

209 to

Pump 7 Ps

412 ft

RECORD

Cased in., ft.

Sand

Gas

Oil

Total Depth 2565

PRODUCTION

1st 24 hrs. Nat.

1st 24 hrs. after shot

Gas Cu. Ft.

Dry Hole

Abandoned

Date

JUL 21 1948

19

S. J. LEWIS

Scout