


Section 35 Township 27 Range 4E

Well No. 16 Starkey

Company Sinclair-Prairie et al

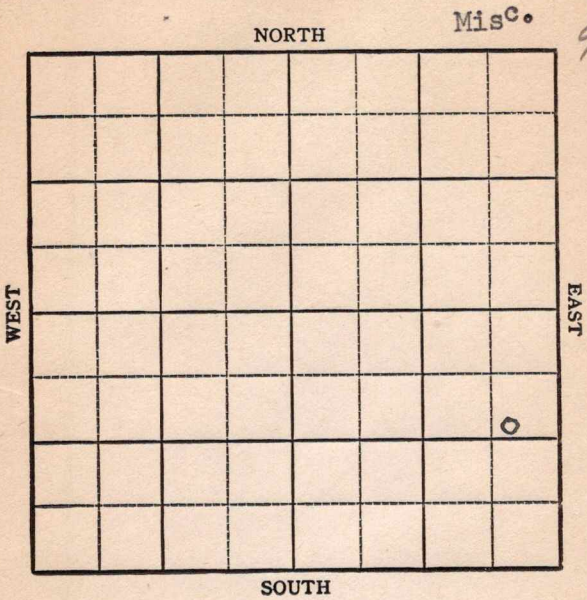

KANSAS

Butler

Sec. 35 Twp. 27 R. 4EWell No. #16 Starkey FarmSinclair-Prairie et al Company

Miscellaneous


1190' Ft. from N. Line

Ft. from S. Line

460' Ft. from E. Line

Ft. from W. Line

SE NE SE

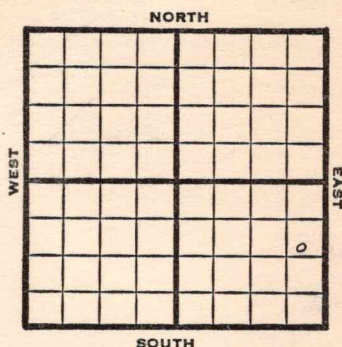

1949

lev 1297' REPORT

1/5 Location

1/12 "

1/19 "

1/26 "

2/2 "

2/9 Location

2/16 Mach.

2/23 "

3/2 "

3/8 Spud

3/16 15" @ 98'

Drlg. 390'

3/23 Drlg 680'

3/30 Drlg. 915'

4/6 Drlg. 1230'

4/12 12" @ 749'

10" @ 1424'

8" @ 1680'

KC 2030'

Drlg. 2195'

4/20 Simpson 2511'

TD 2512'

7" @ 2512'

4/27 TD 2533'

Arb. 2527'

5" @ 2512'

Pump 40 Oil Pot

38° Gr.

Comp COMPLETED

Map No. _____ Sec. 35 Twp. 27 R. 4EWell No. 16 StarkeySinclair-Prairie etal. CompanyFIRST REPORT Contractor

SE NE SE


SECTION PLAT

1190 Ft. from N. Line

_____ Ft. from S. Line

460 Ft. from E. Line

_____ Ft. from W. Line

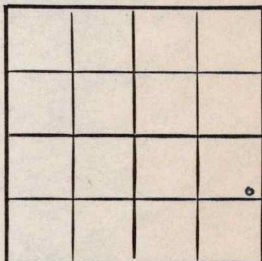Butler County

RECORD

Location X

Cased _____ in., _____ ft.

Rig up _____

Sand _____

Drilling and Remarks:

Gas _____

Oil _____

Total Depth _____

PRODUCTION

1st 24 hrs. Nat. _____

1st 24 hrs. after shot _____

Gas _____ Cu. Ft.

Dry Hole _____

Abandoned _____

Date

JAN 5 1949 19S. J. LEWIS Scout

Map No. K11 Sec. 35 Twp. 27 R. 4E

Well No. 16 Starkey

Sinclair-Prairie etal. Company

COMPLETE

Contractor

SE NE SE

E 11287
SECTION PLAT


1190 Ft. from N. Line

_____ Ft. from S. Line

460 Ft. from E. Line

_____ Ft. from W. Line

Butler County

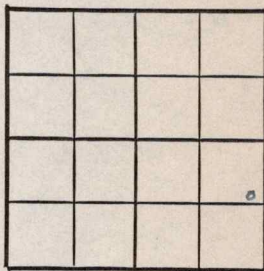

Location _____

Rig up _____

Drilling and Remarks:

See # 2527

see 1102072

Find 40 oil BT

38° S

RECORD

Cased _____ in., _____ ft.

Sand _____

Gas _____

Oil _____

Total Depth 2533

PRODUCTION

1st 24 hrs. Nat. _____

1st 24 hrs. after shot _____

Gas _____ Cu. Ft.

Dry Hole _____

Abandoned _____

Date

APR 27 1949 19

S. J. LEWIS

Scout