


Section 35 Township 27 Range 4-E

Well No. #17 Starkey

Company Sinclair O & G

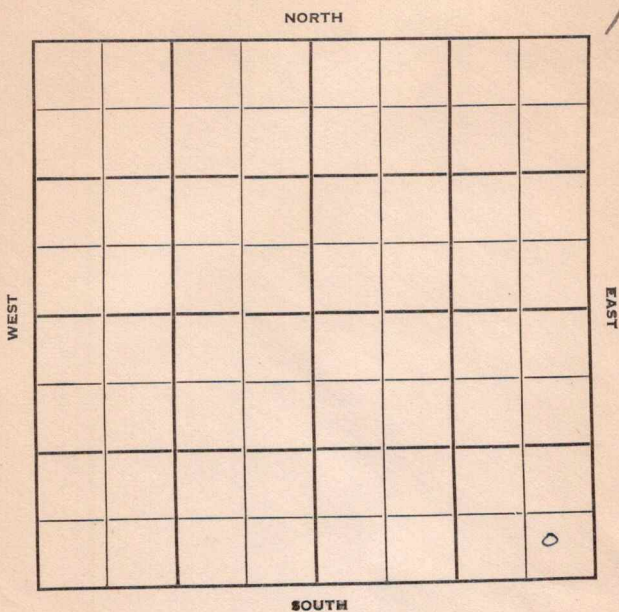

KANSAS

Butler

Sec. 35 Twp. 27 R. 4-E ✓

Well No. #17 Starkey Farm

Sinclair Oil & Gas Company

Augusta Contractor


 Ft. from N. Line

330 Ft. from S. Line

400 Ft. from E. Line

 Ft. from W. Line

SE SE SE

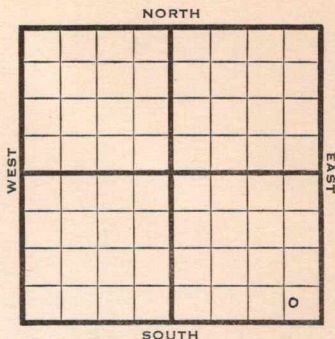

1950

Elev 1291

REPORT

7/19

Location

8/16

10" @ 88

KC 2056

Simp 2512

Sd 2521

Arb 2545-53

7" @ 2509

TD 2553

P/28 bo 3 hr

Comp 50 bopd

Completed

COMPLETED

Map No. _____ Sec. 35 Twp. 27 R. 4EWell No. 17 Starkey_____ Sinclair Oil & Gas Company

_____ Contractor

SE SE SE

SECTION PLAT

_____ Ft. from N. Line

330 Ft. from S. Line400 Ft. from E. Line

_____ Ft. from W. Line



Butler County

Location X

Rig up _____

Drilling and Remarks:

RECORD

Cased _____ in., _____ ft.

Sand _____

Gas _____

Oil _____

Total Depth _____

PRODUCTION

1st 24 hrs. Nat. _____

1st 24 hrs. after shot _____

Gas _____ Cu. Ft.

Dry Hole _____

Abandoned _____

Date

JUL 19 195019J. E. TYRA

Scout

J. E. TYRA