


Map No. _____ Sec. 11 Twp. 25 R. 12 ✓✓Well No. 1 B. Harris FarmWichita Partners Company

NORTH

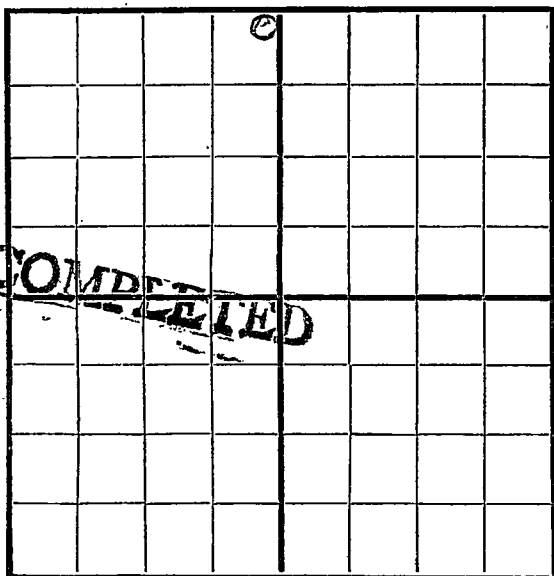

SOUTH

Location _____

Drilling Remarks

750

Rig Up _____

Drilling Remarks

RECORD

Cased _____ in. _____ Ft.

Sand _____

Gas _____

Oil _____

Total Depth _____

PRODUCTION

1st 24 hrs. Nat. _____

1st 24 hrs. after shot _____


Gas _____ Cu. Ft.

Dry Hole _____

Abandoned _____

Map No. _____ Sec. 11 Twp. 26 R. 12
 Well No. 1 B. Burris Farm _____
Wichita Partners Company _____

NORTH

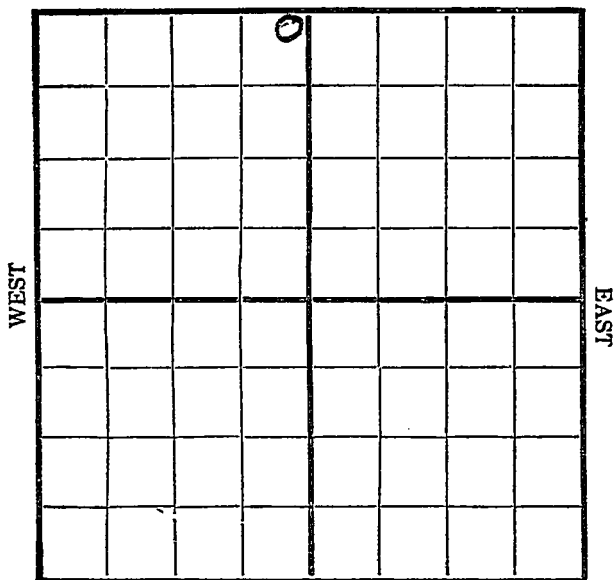

SOUTH

Location _____

Rig Up _____

Drilling and remarks _____

76-8

RECORD

Cased _____ in. _____ Ft.

Sand _____

Gas _____

Oil _____

Total Depth _____

PRODUCTION

1st 24 hrs. Nat. _____

First 24 h.s. after shot _____

Gas _____ Cu. Ft.

Dry Hole _____

Abandoned _____


Date

7/30, 1916 L. H. Farnsworth _____

Map No. 1116 Sec. 11 Twp. 25 R. 12Well No. 1 Burris
Michita Parties Company

Contractor

NORTH

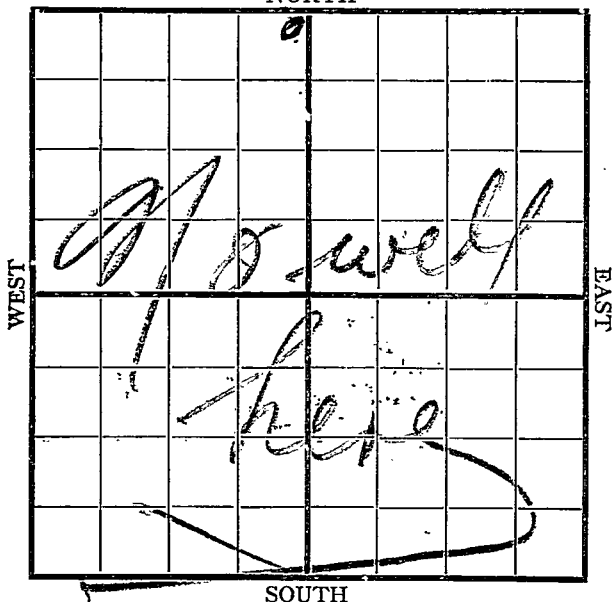

SOUTH

Location _____

Rig up _____

Drilling and Remarks:

750'

RECORD

Cased _____ in., _____ ft.

Sand _____

Gas _____

Oil _____

Total Depth _____

PRODUCTION

1st 24 hrs. Nat. _____

1st 24 hrs. after shot _____

Gas _____ Cu. Ft.

Dry Hole _____

Abandoned _____

Date

7/30 1916 Farnsworth Scout