


Kansas

Map No. _____ Sec. 35 Twp. 25 R. 10Well No. 1 Town lot Farm _____Nye Etal Company _____

NORTH

WEST

EAST

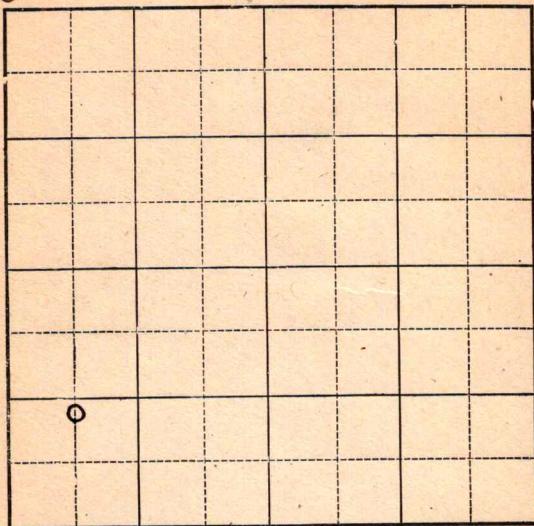

SOUTH

FIRST REPORT
COMPLETED

Location _____

Rig Up _____

Drilling Remarks:

Drilling Remarks:

RECORD

Cased _____ in. _____ ft.

Sand _____

Gas _____

Oil _____

Total Depth _____

PRODUCTION

1st 24 hrs. Nat. _____

1st 24 hrs. after shot _____

Gas _____ cu. ft.

Dry Hole _____

Abandoned _____

Map No. _____ Sec. 35 Twp. 25 R. 10


Well No. 1 Town lot Farm _____
Nye Ekal Company _____

_____ Ft. from N. Line

1120 Ft. from S. Line

_____ Ft. from E. Line

660 Ft. from W. Line

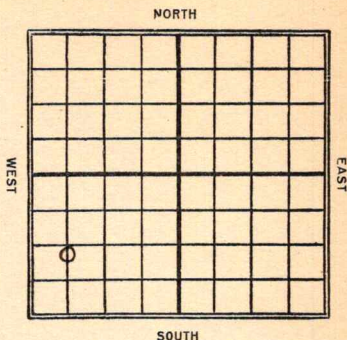

Date	REPORT
1922	
10/26	Dlg. 1100'
11/24	Sand 1992-2025-201806
	Nat.

Map No. **KANSAS** ¹⁶ Sec. ³⁵ Twp. ²⁵ R. ¹⁰Well No. 1 Town platNye plat Company

Contractor

FIRST REPORT

SECTION PLAT

Ft. from N. Line

1120 Ft. from S. Line

Ft. from E. Line

660 Ft. from W. Line

9			

Location -----

Rig up -----

Drilling and Remarks:

1120'

RECORD

Cased ----- in., ----- ft.

Sand -----

Gas -----

Oil -----

Total Depth -----

PRODUCTION

1st 24 hrs. Nat. -----

1st 24 hrs. after shot -----

Gas ----- Cu. Ft.

Dry Hole -----

Abandoned -----

Date

OCT 26 1922

191

M. A. BENEAR

Scout

Map No. ¹⁶**KANSAS** Sec. **35** Twp. **25** R. **10**Well No. **1 Town lot****Mye et al** Company

Contractor

COMPLETED**SECTION PLAT**

Ft. from N. Line

1120 Ft. from S. Line

Ft. from E. Line

6600 Ft. from W. Line

0			

Location

Rig up

Drilling and Remarks:

Top line 1976**RECORD**

Cased in., ft.

Sand

Gas

Oil **1992-2025**Total Depth **2025****PRODUCTION**1st 24 hrs. Nat. **20**

1st 24 hrs. after shot

Gas Cu. Ft.

Dry Hole

Abandoned

Date

NOV 24 1929**M. A. BENEAR**

Scout