

Greenwood


KANSAS




Section 32 Township 25 Range 11-E

Well No. 1 Carter

Company Basinger & Harrington

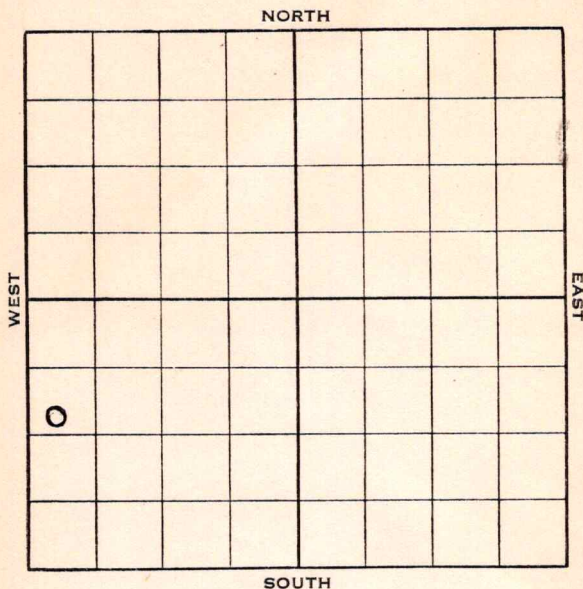

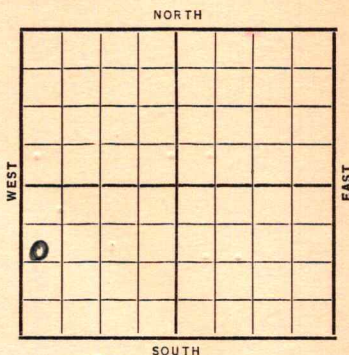Sec. 32 Twp. 25 R. 11-EWell No. #1 Carter FarmBasinger & Harrington Company1150 Ft. from N. Line Ft. from S. Line Ft. from E. Line300 Ft. from W. Line

Date	REPORT
1938	
3/9	R U M
3/18	"
3/25	Drlg. 300'.
4/1	Drlg. 510'.
4/8	12" @ 65'. T.D. 560'.
	SD repairs.
4/15	10" @ 560'. Drlg. 750'.
4/22	Rng. 8" @ 850'.
4/29	8" @ 700'. Drlg. 990'.
5/6	6" @ 1320'. Drlg. 1400'.
5/12	Cattleman sand 1673-80' S.O.
	Drlg. 1750'.
5/20	5" @ 1962'. Miss. 1970'.
	Drlg. 2048'.
5/27	T.D. 2105'. H.F.W.
	P.B. 1319'. Cem. 5" @ 1276'.
6/3	1000 acid. Pump 50 oil in 14 hours. S. W.
6/10	P.B. 1315'.
6/17	3000 acid.

OVER

1938

6/24 P.B. 1315'.
3000 acid.

7/1 P.B. 1304'

7/8 " "

7/15 Testing.

7/22 "

7/29 "

8/5 "

8/12 "

8/19 "

8/26 "

9/2 "

9/9 "

9/16 "

9/23 "

9/30 "

10/7 "

10/12 5" at 1276'.

Miss. 1970'.

T. D. 2105' H.F.W.

P. B. 1319'.

4000 acid.

ABANDONED

Map No. 16^N Sec. 32 Twp. 25 R. 11EWell No. 1 CarterBasinger & Harrington Company

Contractor

FIRST REPORT

SW NW SW

1150 Ft. from N. Line

_____ Ft. from S. Line

_____ Ft. from E. Line

300 Ft. from W. Line

SECTION PLAT

0			

Location _____

Rig up _____

Drilling and Remarks:

RUM

RECORD

Cased _____ in., _____ ft.

Sand _____

Gas _____

Oil _____

Total Depth _____

PRODUCTION

1st 24 hrs. Nat. _____

1st 24 hrs. after shot _____

Gas _____ Cu. Ft.

Dry Hole _____

Abandoned _____

Date

MAR 9 - 1938

19

H. D. Hatfield Scout

Map No. 16 Sec. 32 Twp. 25 R. 11EWell No. 1 CarterBasinger & Harrington Company

Contractor

ABANDONED
SW NW SW1150 Ft. from N. Line Ft. from S. Line Ft. from E. Line300 Ft. from W. Line

SECTION PLAT

0			

Location Rig up

Drilling and Remarks:

PB 1319
4000 and

DVA

RECORD

Cased 5 in., 1276 ft.Sand MISS 1970Gas Oil Total Depth 2105 HFW

PRODUCTION

1st 24 hrs. Nat. 1st 24 hrs. after shot Gas Cu. Ft.Dry Hole Abandoned

Date

OCT 12 1938

19

H. D. Hatfield Scout