


Map No. **KANSAS** Sec. 10 Twp. 23 R. 9
Well No. 15 Green Farm _____
Greenland Oil Company

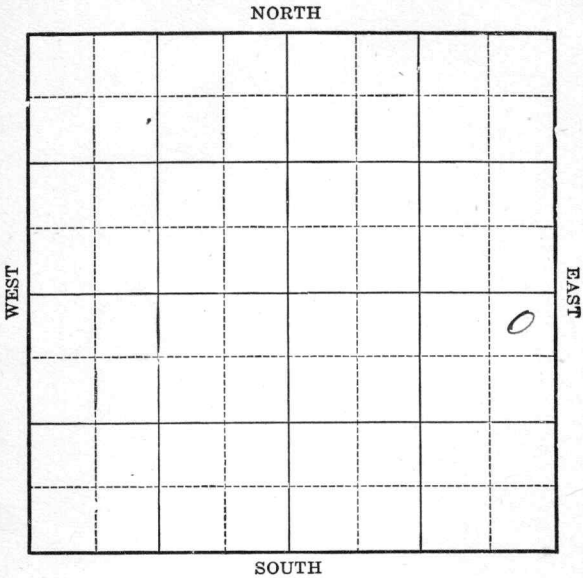

Location _____
Drilling Remarks _____

Rig Up _____
Drilling Remarks _____

RECORD

Cased _____ in. _____ ft.
Sand _____
Gas _____
Oil _____
Total Depth _____

PRODUCTION

1st 24 hrs. Nat. _____
1st. 24 hrs. after shot _____
Gas _____ cu. ft.
Dry Hole _____
Abandoned _____


Map No. Kans 10 Sec. 10 Twp. 23 R. 9
 Well No. 15 Green Farm
Greenland Oil Company

330 Ft. from N. Line

Ft. from S. Line

330 Ft. from E. Line

Ft. from W. Line

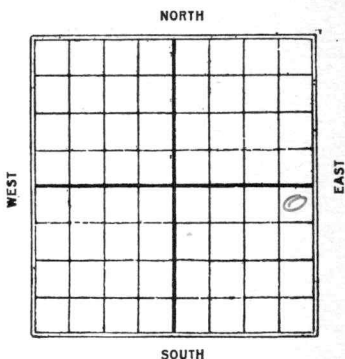

1925

Date REPORT

8/7 Rig on Ground.

8/14 Rig.

8/20 200'

8/26 1100'

9/3 SD. 1550'

9/11 —————

9/16 Lately 1350'

9/24 —————

10/11 Sand 2339-64 80 gals
 300 Bbls

Sherwood Co

15 KANSAS Map No. _____ Sec. 10 Twp. 23 R. 9

Well No. 15, Sherwood

Sherwood Land Co. Company

Contractor

COMPLETED

330 Ft. from N. Line

Ft. from S. Line

330 Ft. from E. Line

Ft. from W. Line

SECTION PLAT

			0

Location _____

Rig up _____

Drilling and Remarks:

809 300 bhs.

RECORD

Cased _____ in., _____ ft.

Sand 2339-2364

Gas _____

Oil _____

Total Depth 2364

PRODUCTION

1st 24 hrs. Nat. _____

1st 24 hrs. after shot _____

Gas _____ Cu. Ft.

Dry Hole _____

Abandoned _____

Date

OCT 1 1925

CHAS. L. SHERWOOD

Scout