


KANSAS

Greenwood ✓

Section 13 ~~36~~ Township 25S ~~24~~ Range 12E
Well No. Canon ~~#2 McGonough~~
Company Ed. Ashlock et al.
Miscellaneous

NORTH

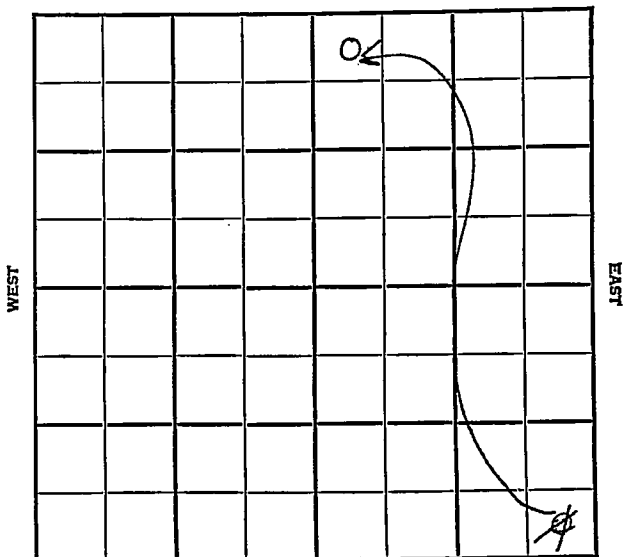

SOUTH

KANSAS

Greenwood

Sec. 36 13 Twp. 25 24 R. 12E

Well No. #2 McCannaughey Canon Farm

Ed. Ashlock et al

Company


Misc.

330 Ft. from N. Line

330 Ft. from S. Line

330 Ft. from E. Line

330 Ft. from W. Line

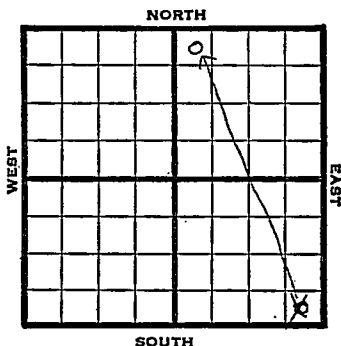

~~SE/E~~ NW NE

1948

REPORT

6/1 Drlg. 600'

6/9 Sd 1346-1361'

5" @ 1342'

150' oil

6/16 TD 1371'-

Sand 1346'

5"@ 1342'

30 qts.

Pump 25 Oil Pot

38° Gr.

Comp.

COMPLETED

Map No. _____ Sec. 36 Twp. 24 R. 12E

Well No. 2 McConnaughey

Ed. Ashlock et al. _____ Company

FIRST REPORT

Contractor

SE/C

SECTION PLAT

_____ Ft. from N. Line

330 Ft. from S. Line

330 Ft. from E. Line

_____ Ft. from W. Line

Greenwood County

Location _____

Rig up _____

Drilling and Remarks:

drlg. 600

RECORD

Cased _____ in., _____ ft.

Sand _____

Gas _____

Oil _____

Total Depth _____

PRODUCTION

1st 24 hrs. Nat. _____

1st 24 hrs. after shot _____

Gas _____ Cu. Ft.

Dry Hole _____

Abandoned _____

Date

JUN 1 1948

S. J. LEWIS

Scout

Map No. 16 Sec. 13 Twp. 25 R. 12E

Well No. 2 Canon

Ed Ashlock et al. Company

CORRECTION

Contractor

NW NE

SECTION PLAT

		o	

330 Ft. from N. Line

_____ Ft. from S. Line

_____ Ft. from E. Line

330 Ft. from W. Line

Greenwood County

Location _____

Rig up _____

Drilling and Remarks:

Correct fl measurements
Scout

Reported

#2 McConnaughey

36-24-12E

RECORD

Cased _____ in., _____ ft.

Sand _____

Gas _____

Oil _____

Total Depth _____

PRODUCTION

1st 24 hrs. Nat. _____

1st 24 hrs. after shot _____

Gas _____ Cu. Ft.

Dry Hole _____

Abandoned _____

Date

JUN 9 1948 19

S. J. LEWIS Scout

Map No. 16 Sec. 13 Twp. 25 R. 12E

Well No. 2 Cannon

Ed Ashlock et al. Company

COMPLETE Contractor

NW NE

SECTION PLAT

330 Ft. from N. Line

 Ft. from S. Line

 Ft. from E. Line

330 Ft. from W. Line

		0	

Greenwood County

Location

Rig up

Drilling and Remarks:

Sand 1346

5" @ 1342

30 ft

Pump 25 oil 188

38 ft

RECORD

Cased in., ft.

Sand

Gas

Oil ✓

Total Depth 132

PRODUCTION

1st 24 hrs. Nat.

1st 24 hrs. after shot

Gas Cu. Ft.

Dry Hole

Abandoned

Date

JUN 16 1948 19 S. J. LEWIS Scout