


Section 31 Township 25 Range 11-EWell No. #3 GilsonCompany Mendenhall Drlg.

NORTH

WEST

EAST

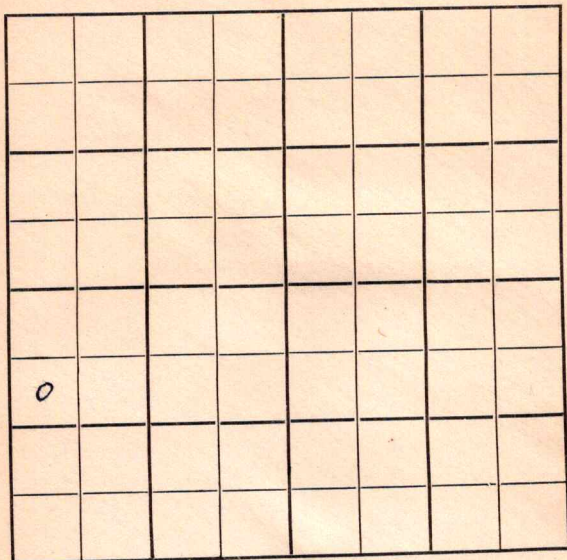

SOUTH

KANSAS

Greenwood

Sec. 31 Twp. 25 R. 11-E

Well No. #3 Gilson Farm

Mendenhall Drlg.

Company

Mendenhall Drlg.

Contractor

990

Ft. from N. Line


Ft. from S. Line

Ft. from E. Line

330

Ft. from W. Line

SW NW SW

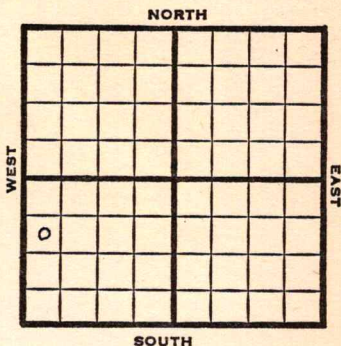

1950

?

REPORT

10/18

Cellar & Pits

12/6

Spud 10-19-50

8 5/8" @ 25

Miss 1967

5" @ 1972

TD 1983

1000 A

Comp 30 bopd

Completed

COMPLETED

County Greenwood State KansasSec. 31 (Blk.
Twp.) 25 (Sur.
Rge.) 11E Map No.Operator Mendenhall Drlg.Well No. 3 Farm GilsonElev. Location SW NW SW990 Ft. From N Line SW330 Ft. From W Line Quarter

1st. Report

Completion DEC 6 1950

Remarks

Mendenhall - Contr.Spudding Date 10-19-50Drlg. Data Oil well TD 19838 5/8" @ 25 Miss. 1967 5" @ 1972TD 1983 1000 A Comp. 30 bopd