

Greenwood County, Kansas

FORM 51 10M 8-47

KANSAS

Section 22 Township 25 Range 11E

Well No. #1 Parks

Company McGinnis & Cox

NORTH

			0				

SOUTH

WEST

EAST

KANSAS

Greenwood

Sec. 22 Twp. 25 R. 11E

Well No. #1 Parks Farm

McGinnis & Cox Company
Misc.


330 Ft. from N. Line

Ft. from S. Line

330 Ft. from E. Line

Ft. from W. Line

NE NW

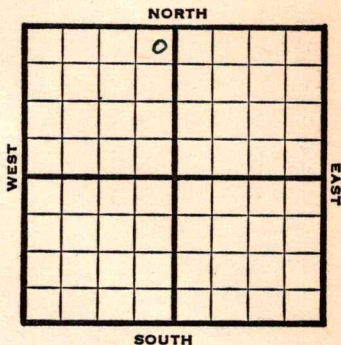

1947

REPORT

12/30

12" @ 100'

Drlg. 1810'

1948

1/7

"

1/14

Miss. 1945'

TD 1976'

Abd.

ABANDONED

Map No. _____ Sec. 22 Twp. 25 R. 11E

Well No. 1 Parks


McGinnis & Cox Company

FIRST REPORT

Contractor

NE NW

SECTION PLAT

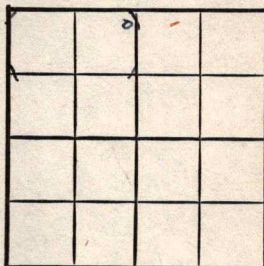

330 Ft. from N. Line

_____ Ft. from S. Line

330 Ft. from E. Line

_____ Ft. from W. Line

Greenwood County

Location _____

Rig up _____

Drilling and Remarks:

12" @ 100

drlg. 1810

RECORD

Cased _____ in., _____ ft.

Sand _____

Gas _____

Oil _____

Total Depth _____

PRODUCTION

1st 24 hrs. Nat. _____

1st 24 hrs. after shot _____

Gas _____ Cu. Ft.

Dry Hole _____

Abandoned _____

Date

DEC 3 0 1947

19

S. J. LEWIS

Scout

Map No. 16 Sec. 22 Twp. 25 R. 11E

Well No. 1 Parks

McGinnis & Cox

Company

ABANDONED

Contractor

NE NW

SECTION PLAT

330 Ft. from N. Line

Ft. from S. Line

330 Ft. from E. Line

Ft. from W. Line

Greenwood County

RECORD

Location

Cased _____ in., _____ ft.

Rig up

Sand _____

Drilling and Remarks:

Gas _____

Oil _____

Total Depth 1976

PRODUCTION

1st 24 hrs. Nat. _____

1st 24 hrs. after shot _____

Gas _____ Cu. Ft.

Dry Hole _____

Abandoned _____

Date

JAN 14 1948 19

S. J. LEWIS Scout