


Map No. _____ Sec. 25 Twp. 75 R. 11 ✓Well No. 1 Dolson Farm _____McKinna et al Company _____

NORTH

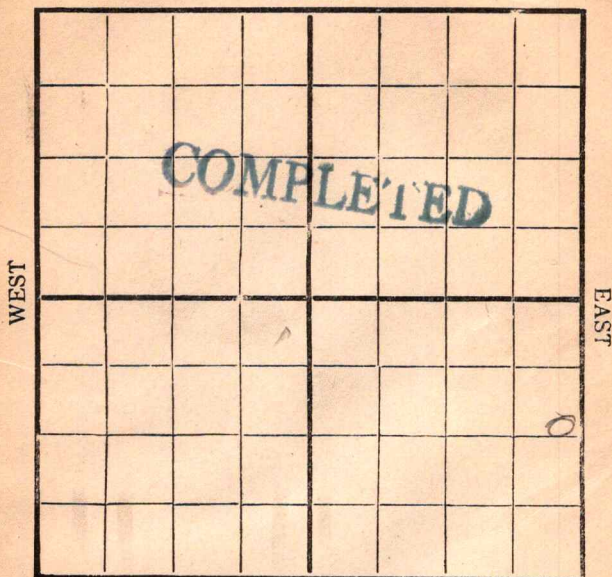

SOUTH

Location _____

Rig Up _____

Drilling Remarks:

Drilling Remarks:

RECORD

Cased _____ in _____ Ft.

Sand _____

Gas _____

Oil _____

Total Depth _____

PRODUCTION

1st 24 hrs. Nat. _____

1st 24 hrs. after shot _____

Gas _____ Cu. Ft.

Dry Hole _____

Abandoned _____

Greenwood

Map No. _____


Sec. *25*Twp. *35*R. *11*Well No. *1**Dolson*

Farm

W. C. Guins et al

Company

NORTH

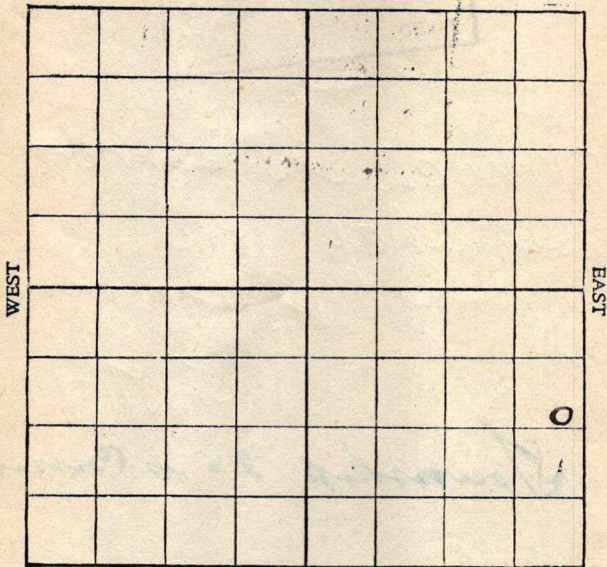

SOUTH

Location _____

Rig up _____

Drilling and remarks:

Spudding

RECORD

Cased _____ in. _____ Ft.

Sand _____

Gas _____

Oil _____

Total Depth _____

PRODUCTION

1st 24 hrs. Nat. _____

1st 24 hrs. after shot _____

Gas _____ Cu. Ft.

Dry Hole _____

Abandoned _____

Date


5/12, 191*7*, *Brocker* Scout

Map No. *15-16* Sec. *25* Twp. *25* R. *11*Well No. *1 Dolson* Farm*M. J. Guinis et al* Company

NORTH

WEST

EAST

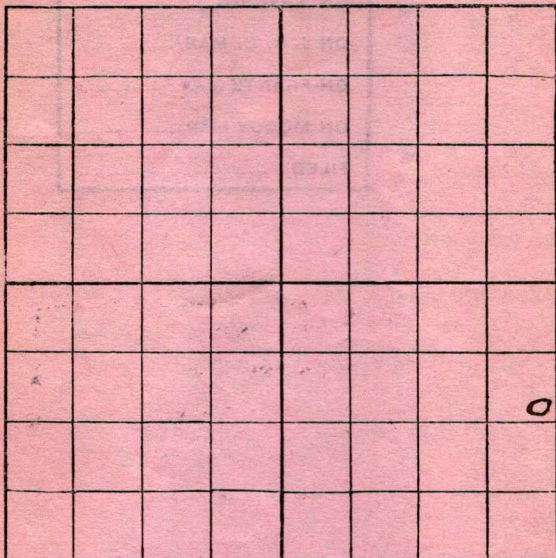

SOUTH

Location _____

Rig up _____

Drilling and remarks:

D-200'

RECORD

Cased _____ in. _____ Ft.

Sand _____

Gas _____

Oil _____

Total Depth _____

PRODUCTION

1st 24 hrs. Nat. _____

1st 24 hrs. after shot _____

Gas _____ Cu. Ft.

Dry Hole _____


Abandoned _____

Date

5/7/97, 19*97*, *Procker* Scout

Map No. *K14* Sec. *25* Twp. *25* R. *11*Well No. *1 Dolson* Farm*M. G. Quins et al* Company

NORTH

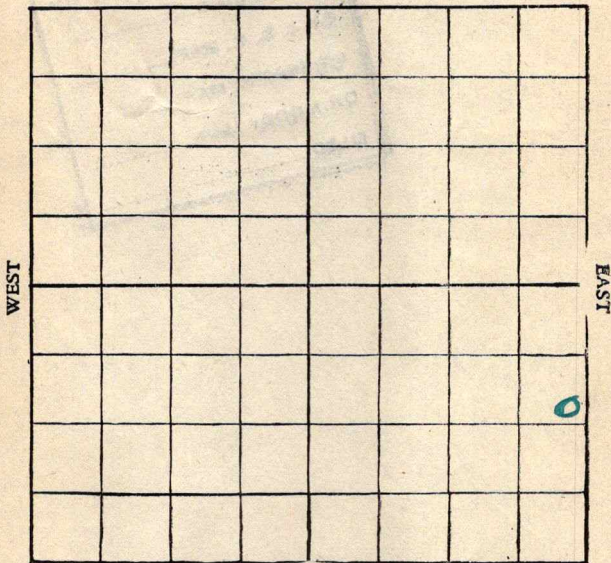

SOUTH

Location -----

Rig up -----

Drilling and remarks:

Spud in 100
C.D.

RECORD

Cased ----- in. ----- Ft.

Sand -----

Gas -----

Oil -----

Total Depth -----

PRODUCTION

1st 24 hrs. Nat. -----

1st 24 hrs. after shot -----

Gas ----- Cu. Ft.

Dry Hole -----

Abandoned -----


Date

5/26, 191*7*, *Dropper* Scout

Greenwood

Map No. _____ Sec. 25 Twp. 25 R. 11Well No. 1 Dolson FarmM. G. Guins et al Company

NORTH

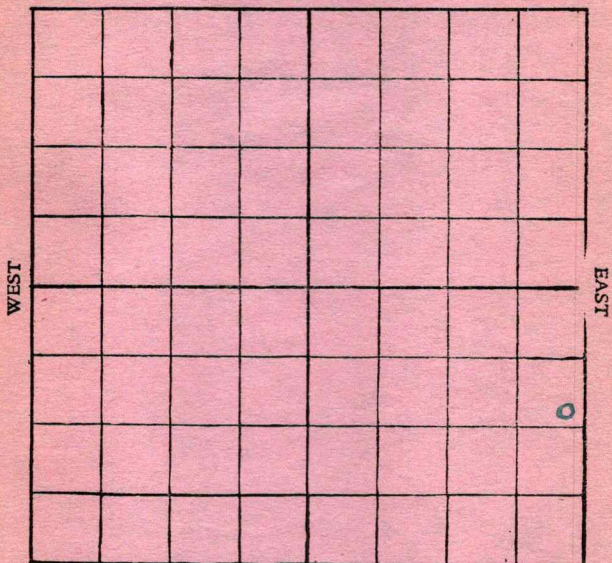

SOUTH

Location _____

Rig up _____

Drilling and remarks:

D-600

RECORD

Cased _____ in. _____ Ft.

Sand _____

Gas _____

Oil _____

Total Depth _____

PRODUCTION

1st 24 hrs. Nat. _____

1st 24 hrs. after shot _____

Gas _____ Cu. Ft.

Dry Hole _____

Abandoned _____


Date

6/2, 1917 Brocker Scout

Greenwood

Map No. _____ Sec. 25 Twp. 25 R. 11Well No. 1 Dobson Farm _____M. C. Guinness et al Company _____

NORTH

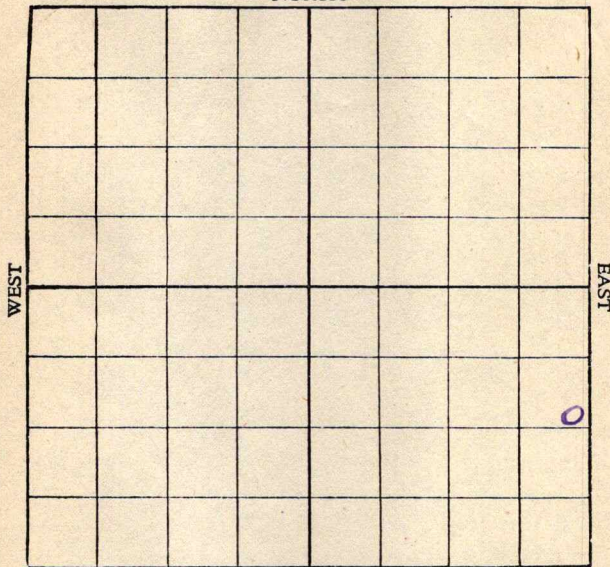

SOUTH

Location _____

Rig up _____

Drilling and remarks:

N.D. 850'
for Case

RECORD

Cased _____ in. _____ Ft.

Sand _____

Gas _____

Oil _____

Total Depth _____

PRODUCTION

1st 24 hrs. Nat. _____

1st 24 hrs. after shot _____

Gas _____ Cu. Ft.

Dry Hole _____

Abandoned _____

Date

JUN 9 - 1917


, 191

C. T. Crocker
Scout

Greenwood

Map No. _____ Sec. 25 Twp. 25 R. 11Well No. 1 Dolson Farm _____Company M.G. Guins et al

NORTH

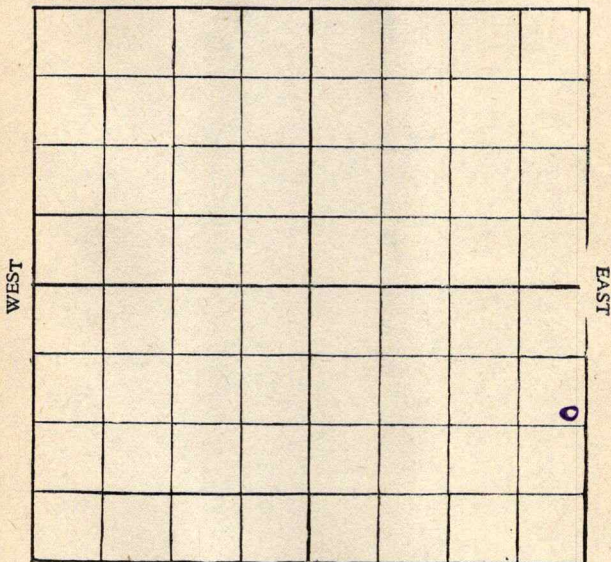

SOUTH

Location _____

Rig up _____

Drilling and remarks:

D-1500'

RECORD

Cased _____ in. _____ Ft.

Sand _____

Gas _____

Oil _____

Total Depth _____

PRODUCTION

1st 24 hrs. Nat. _____

1st 24 hrs. after shot _____

Gas _____ Cu. Ft.

Dry Hole _____

Abandoned _____

Date


JUN 16 1917

, 191

E. J. Crocker Scout

*Greenwood*Map No. _____ Sec. *25* Twp. *25* R. *11*Well No. *1* *Dolson* Farm*M. G. Guinn et al* Company

NORTH

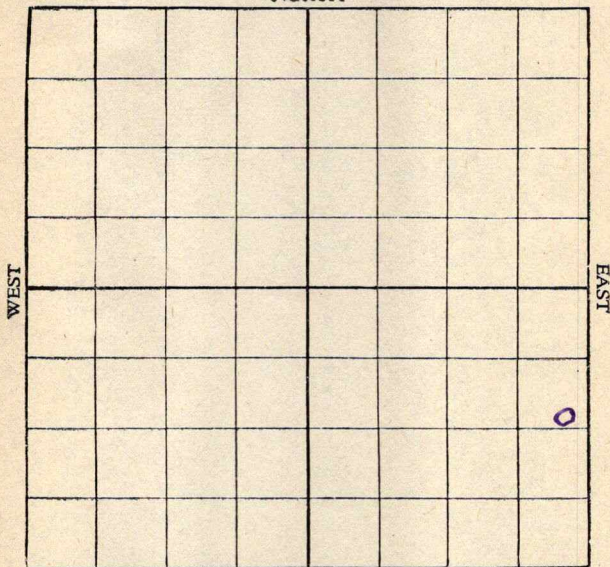

SOUTH

Location _____

Rig up _____

Drilling and remarks:

SD 1500'

RECORD

Cased _____ in, _____ Ft.

Sand _____

Gas _____

Oil _____

Total Depth _____

PRODUCTION

1st 24 hrs, Nat. _____

1st 24 hrs, after shot _____

Gas _____ Cu, Ft.

Dry Hole _____

Abandoned _____

Date

JUN 22 1917


191

E. J. Crocker Scout

Green wood

Map No. _____ Sec. 25 Twp. 25 R. 11Well No. 1 Salson FarmM. Guins et al Company

NORTH

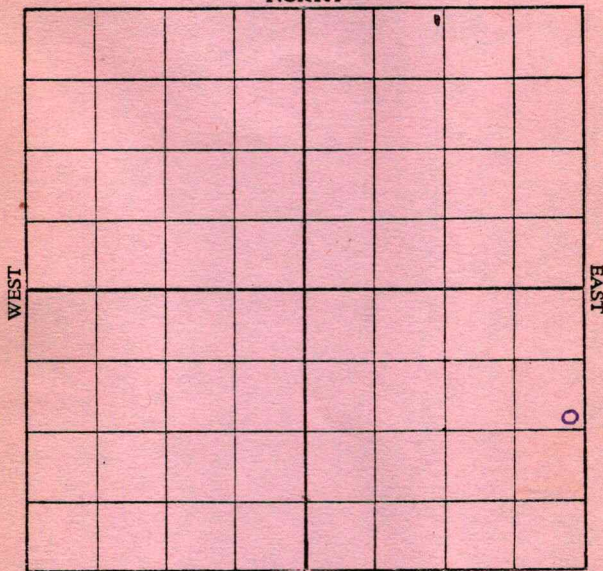

SOUTH

Location _____

Rig up _____

Drilling and remarks:

S.O. - 1500

RECORD

Cased _____ in. _____ Ft.

Sand _____

Gas _____

Oil _____

Total Depth _____

PRODUCTION

1st 24 hrs. Nat. _____

1st 24 hrs. after shot _____

Gas _____ Cu. Ft.

Dry Hole _____


Abandoned _____

Date JUN 30 1917

_____, 191____, C. T. Crocker Scout

Map No. _____ Sec. 25 Twp. 25 R. 11Well No. 1 Dolson Farm __________W. G. Quinn & Co. Company

NORTH

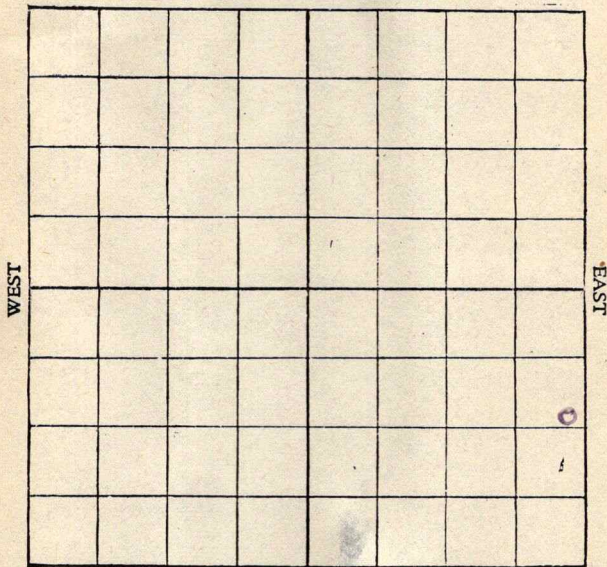

SOUTH

Location _____

Rig up _____

Drilling and remarks:

S.D. 1500'

RECORD

Cased _____ in. _____ Ft.

Sand _____

Gas _____

Oil _____

Total Depth _____

PRODUCTION

1st 24 hrs. Nat. _____

1st 24 hrs. after shot _____

Gas _____ Cu. Ft.

Dry Hole _____

Abandoned _____


Date

JUL 7 1917, 191G. J. Crocker Scout

Green wood

Map No. _____ Sec. 25 Twp. 25 R. 11Well No. 1 Dolsen Farm _____McGinnis et al Company

NORTH

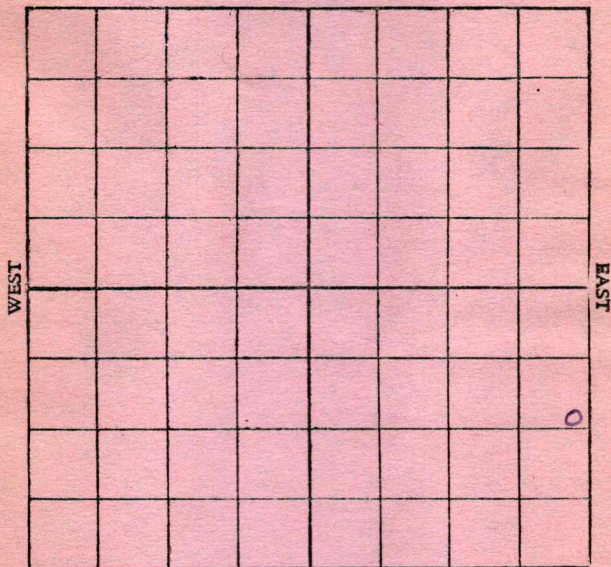

SOUTH

Location _____

Rig up _____

Drilling and remarks:

RD. 1500'

RECORD

Cased _____ in. _____ Ft.

Sand _____

Gas _____

Oil _____

Total Depth _____

PRODUCTION

1st 24 hrs. Nat. _____

1st 24 hrs. after shot _____

Gas _____ Cu. Ft.

Dry Hole _____

Abandoned _____

Date

JUL 14 1917


191

C. J. Crocker Scout

Map No. _____ Sec. 25 Twp. 35 R. 11Well No. 1 Dalsou Farm _____Mc Guinness et al Company

NORTH

WEST

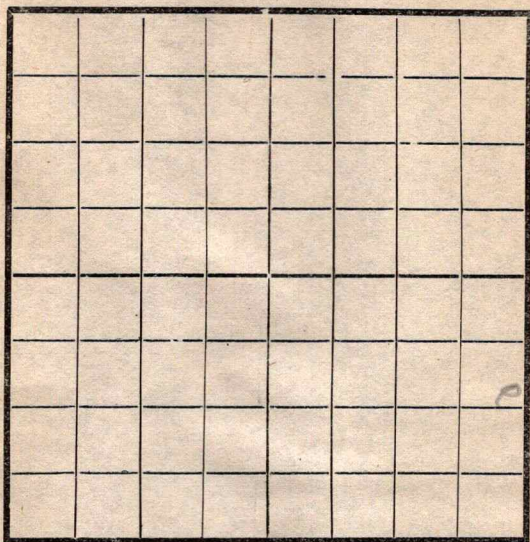

EAST

SOUTH

Location _____

Rig Up _____

Drilling and remarks

1922No showing

RECORD

Cased _____ in. _____ Ft.

Sand 1886-1912

Gas _____

Oil _____

Total Depth _____

PRODUCTION

1st 24 hrs. Nat. _____

1st 24 hrs. after shot _____

Gas _____ Cu. Ft.

Dry Hole _____


Abandoned _____

Date

7/17, 1917 C. D. C. Scout

Map No. _____ Sec. 25 Twp. 25 R. 11Well No. 1 Dolson Farm
McGinnis & Co Company

NORTH

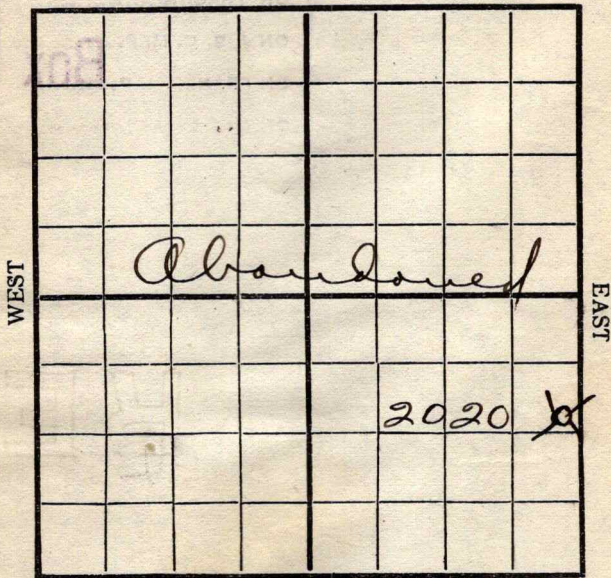

SOUTH

Location _____

Rig Up _____

Drilling and remarks _____

*Dry and
abandoned
2020
(Greenwood Co)*

RECORD

Cased _____ in. _____ Ft.

Sand 1886-1912 Dry

Gas _____

Oil _____

Total Depth _____

PRODUCTION

1st 24 hrs. Nat. _____

1st 24 hrs. after shot _____

Gas _____ Cu. Ft.

Dry Hole _____

Abandoned _____

Date

8/1, 1917 Carley Scout

Map No. _____ Sec. 75 Twp. 75 R. 11Well No. 1220 Farm McGinnis et al
Company _____

NORTH

WEST

EAST

SOUTH

Location _____

Rig Up _____

Drilling and remarks _____

RECORD

Cased _____ in. _____ Ft.

Sand _____

Gas _____

Oil _____

Total Depth _____

PRODUCTION

1st 24 hrs. Nat. _____

1st 24 hrs. after shot _____

Gas _____ Cu. Ft.

Dry Hole ☒ _____Abandoned 2020 _____

Date

9-5, 1917 Lantz Scout