

Greenwood


KANSAS

FORM 51 5M 2-38 TPCO.

Section 32 Township 25 Range 11-E

Well No. #1 Culter

Company Greenway Oil

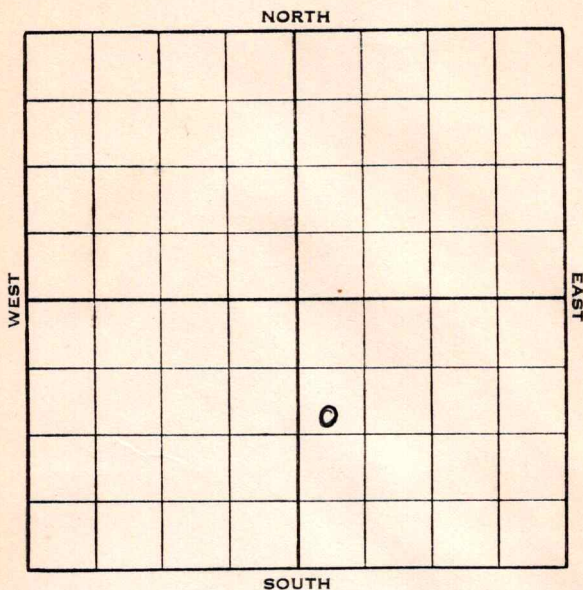

Greenwood **KANSAS**Map No. 16 Sec. 32 Twp. 25 R. 11EWell No. 1 CulterGreenway Oil

Company

Contractor

FIRST REPORT

SW NW SE

1150 Ft. from N. Line Ft. from S. Line Ft. from E. Line300 Ft. from W. Line**SECTION PLAT**

		0	.

Location Rig up

Drilling and Remarks:

RU Mach**RECORD**Cased in., ft.Sand Gas Oil Total Depth **PRODUCTION**1st 24 hrs. Nat. 1st 24 hrs. after shot Gas Cu. Ft.Dry Hole Abandoned

Date

JUL 6 - 1938

19

H. D. Hatfield

Scout

Greenwood

KANSAS

Map No. 16 Sec. 32 Twp. 25 R. 11EWell No. 1 CulterGreenway Oil

Company

Contractor

ABANDONED

SW NW SE

1150 Ft. from N. Line Ft. from S. Line Ft. from E. Line300 Ft. from W. Line

SECTION PLAT

		0	

Location Rig up

Drilling and Remarks:

abd

RECORD

Cased in., ft.Sand Gas Oil Total Depth 760

PRODUCTION

1st 24 hrs. Nat. 1st 24 hrs. after shot Gas Cu. Ft.Dry Hole Abandoned

Date

OCT 12 1938 19

H. D. Hatfield Scout

What is total depth



Ray

Returned

Cards

Tracing

France Map

Scarborough Map

Moody Map

Scarborough Plat Book

Moody Plat Book

Paul
JMP
Ray
JMP

