
Form 51 5M 8-24 16567

Map No. Kansas Sec. 11 Twp. 23 R. 9

Well No. 1 Green Farm

Ward McGinnis Company

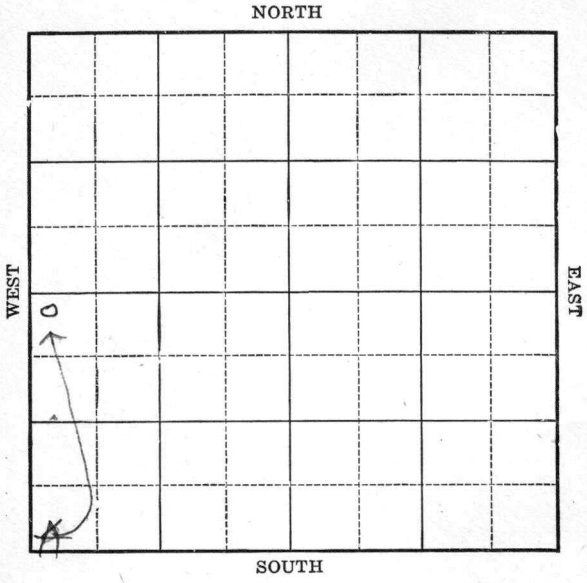

Location

Drilling Remarks

Rig Up

Drilling Remarks

RECORD

Cased in. ft.

Sand

Gas

Oil

Total Depth

PRODUCTION

1st 24 hrs. Nat.

1st. 24 hrs. after shot

Gas cu. ft.

Dry Hole

Abandoned

Form 252A 5M 8-24 16529

Map No. Kansas Sec. 11 Twp. 23 R 9

Well No. 1 Green Farm


Hard-McGinnis Company

330 Ft. from N. Line

~~330~~ Ft. from S. Line

Ft. from E. Line

330 Ft. from W. Line

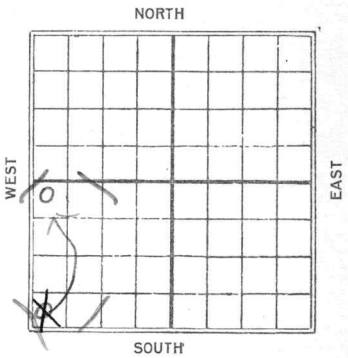

C.S.

Date 1925	REPORT
~~6/10~~ 6/5	Location
6/12	R.O.G.
6/19	Rig
6/26	
7/3	Spud
7/10	520
7/17	1780
7/24	Top L. 2330' Lg in.
7/31	Top Ls 2330' 1st oil 2335' 2 oil 2380' 10 bbl 100 bbls

Form 26—1M Bks.—3-23—11959.

Map No. 12 Hendricks Sec. 11 Twp. 23 R. 9

Well No. 1 Tolson

Ward McDennis Company

Contractor

FIRST REPORTS


Ft. from N. Line

330 Ft. from S. Line

Ft. from E. Line

330 Ft. from W. Line

SECTION PLAT

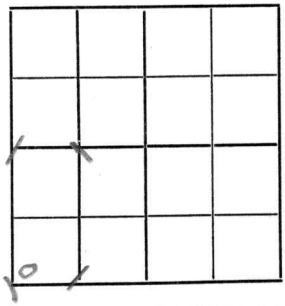

Location ✓

Rig up

Drilling and Remarks:

RECORD

Cased in., ft.

Sand

Gas

Oil

Total Depth

PRODUCTION

1st 24 hrs. Nat.

1st 24 hrs. after shot

Gas Cu. Ft.

Dry Hole

Abandoned

Date

JUN 5 1925

192

CHAS. L. SHERWOOD Scout

Form 26—1M Bks.—3-23—11959.


Map No. 15 Sumner Sec. 11 Twp. 23 R. 9

Well No. 1 (Green)

Ward McDennis Company

Contractor

SECTION PLAT

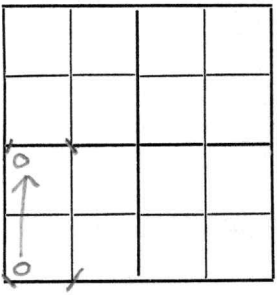

330 Ft. from N. Line

Ft. from S. Line

Ft. from E. Line

330 Ft. from W. Line

CORRECTION

Location

Rig up on ground

Drilling and Remarks:

Rig location to above.

RECORD

Cased in., ft.

Sand

Gas

Oil

Total Depth

PRODUCTION

1st 24 hrs. Nat.

1st 24 hrs. after shot

Gas Cu. Ft.

Dry Hole

Abandoned

Date JUN 12 1925

192 CHAS. L. SHERWOOD Scout

Form 26—1M Bks.—3-23—11959.

Map No. Sands Sec. 11 Twp. 23 R. 9

Well No. 1 Olson

Ward Mc Dinnis Company

Contractor

COMPLETED


330 Ft. from N. Line

Ft. from S. Line

Ft. from E. Line

330 Ft. from W. Line

SECTION PLAT

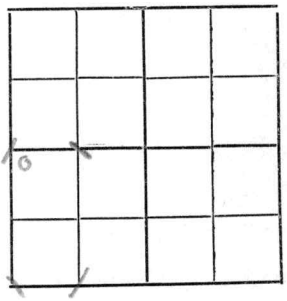

Location

Rig up

Drilling and Remarks:

1st oil 2335'

100/100 bls

RECORD

Cased in., ft.

Sand 2330-2380'

Gas

Oil

Total Depth 2380'

PRODUCTION

1st 24 hrs. Nat.

1st 24 hrs. after shot

Gas Cu. Ft.

Dry Hole

Abandoned

Date

JUL 31 1925

192

CHAS. L. SHERWOOD

Scout