
Form 51 5M 8-24 16567

Map No. Kansas Sec. 11 Twp. 23 R. 9

Well No. 2 Green Farm

Sheedy etal Company

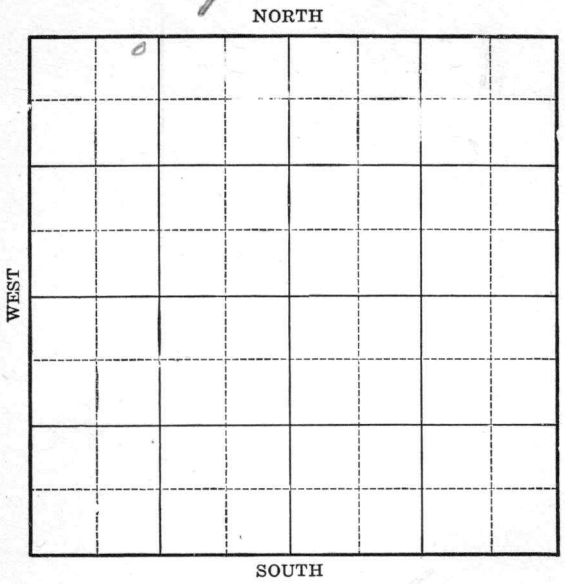

Location

Drilling Remarks

Rig Up

Drilling Remarks

RECORD

Cased in. ft.

Sand

Gas

Oil

Total Depth

PRODUCTION

1st 24 hrs. Nat.

1st. 24 hrs. after shot

Gas cu. ft.

Dry Hole

Abandoned

Form 252A 5M 8-24 16529

Map No. Kansas Sec. 11 Twp. 23 R 9

Well No. 2 Grun Farm


Sheedy etal Company

300 Ft. from N. Line

Ft. from S. Line

Ft. from E. Line

1020 Ft. from W. Line

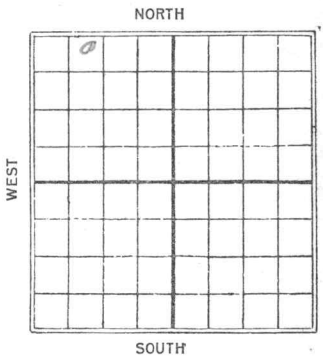

C.

Date 1925	REPORT
5/15	R.O.G.
5/29	Rig
6/5	Spud
6/12	550
6/19	1140
6/26	1600
7/3	1820
7/10	T.D. 2396 Top gas sand 2321-28 shale 2328-35; sdy. sh. 2335-47 gas 2347-61. Oil 2361-96; 100 qts/120 abls

Form 26—1M Bks.—3-23—11959.

Map No. 1 2 Kinds Sec. 11 Twp. 23 R. 9


Well No. 2 Moon

Rhoe Dy & al Company

Contractor

FIRST REPORTS

SECTION PLAT

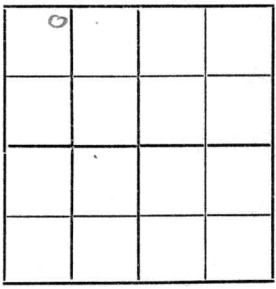

300 Ft. from N. Line

Ft. from S. Line

Ft. from E. Line

1020 Ft. from W. Line

Location

Rig ~~up~~ on ground

Drilling and Remarks:

RECORD

Cased in., ft.

Sand

Gas

Oil

Total Depth

PRODUCTION

1st 24 hrs. Nat.

1st 24 hrs. after shot

Gas Cu. Ft.

Dry Hole

Abandoned

Date

MAY 15 1925

192

CHAS. L. SHERWOOD Scout

Form 26—1M Bks.—3-23—11959.

Map No. 1 Kinds Sec. 11 Twp. 23 R. 9

Well No. 2 Olsen

Shee Dy & A Company

Contractor

COMPLETED


300 Ft. from N. Line

Ft. from S. Line

Ft. from E. Line

1020 Ft. from W. Line

SECTION PLAT

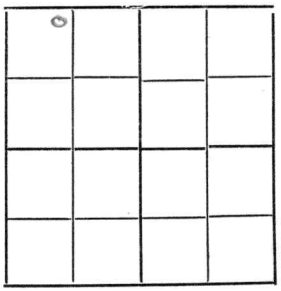

Location

Rig up

Drilling and Remarks:

Top gb ad 2321-28'
shale 2328-35'
Sandy shale 2335-47'
gb 2347-61'
od 2361-96
100 / 120 b/s

RECORD

Cased in., ft.

Sand

Gas

Oil

Total Depth 2396

PRODUCTION

1st 24 hrs. Nat.

1st 24 hrs. after shot

Gas Cu. Ft.

Dry Hole

Abandoned

Date

JUL 10 1925 192 CHAS. L. SHERWOOD Scout