


Map No. Kansas Greenwood Sec. 23 Twp. 25 R. 11

Well No. 1 Naire Farm

Kelly Oil Company

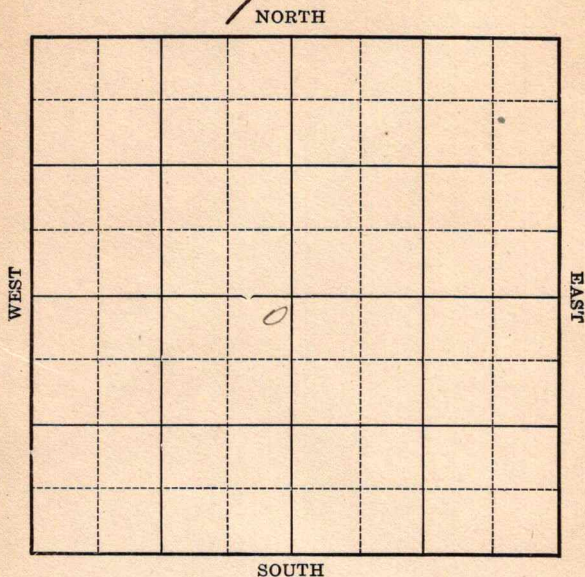

Location _____

Drilling Remarks _____

Rig Up _____

Drilling Remarks _____

RECORD

Cased _____ in. _____ ft.

Sand _____

Gas _____

Oil _____

Total Depth _____

PRODUCTION

1st 24 hrs. Nat. _____

1st 24 hrs. after shot _____

Gas _____ cu. ft.

Dry Hole _____


Abandoned _____

Map No. Kans. Sec. 23 Twp. 25 R 11Well No. # 1 - Haire FarmSkelly Oil Company330 Ft. from N. Line

Ft. from S. Line

330 Ft. from E. Line

Ft. from W. Line

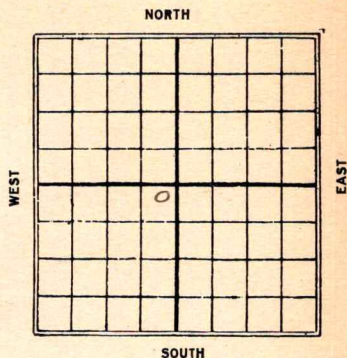1926.

Date

REPORT

5/19 Location6/2 —6/10 same6/18 —6/25 —6/30 —7/18 —7/15 Machine7/22 Rigging up7/28 Spudding8/4 Dlg 30'8/11 " 5258/18 " 7758/25 " 10208/31 " 16759/15 top line 1875Only 21009/22 S.D. 21969/29 I Line 1875; Wil. 2300-25Q & a 2305 - HFW

Sherwood
 Map No. *K16* KANSAS Sec. *23* Twp. *25* R. *11*
 Well No. *1* *Haire*
Sully Oil Co. Company

Contractor

FIRST REPORTS

SECTION PLAT

330 Ft. from N. Line

Ft. from S. Line

330 Ft. from E. Line

Ft. from W. Line

	0		

Location ☒

Rig up

Drilling and Remarks:

RECORD

Cased _____ in., _____ ft.

Sand _____

Gas _____

Oil _____

Total Depth _____

PRODUCTION

1st 24 hrs. Nat. _____

1st 24 hrs. after shot _____

Gas _____ Cu. Ft.

Dry Hole _____

Abandoned _____

Date

MAY 19 1926

192

CHAS. L. SHERWOOD

Scout

Greenwood
 16 **KANSAS** Sec. *23* Twp. *25* R. *11*
 Map No. _____
 Well No. *1 Haire* _____
Steele & Co _____ Company

Contractor _____

COMPLETED**SECTION PLAT***330*

Ft. from N. Line

Ft. from S. Line

330

Ft. from E. Line

Ft. from W. Line

ABANDONED

	o		

Location _____

Rig up _____

Drilling and Remarks:

*th 1875**Milcox 2300-05**DLg 2305**HFV***RECORD**

Cased _____ in., _____ ft.

Sand _____

Gas _____

Oil _____

Total Depth *2305***PRODUCTION**

1st 24 hrs. Nat. _____

1st 24 hrs. after shot _____

Gas _____ Cu. Ft.

Dry Hole ☒Abandoned ☒

Date

SEP 29 1926

CHAS. L. SHERWOOD

192

Scout