



Map No. Kansas Sec. 27 Twp. 25 R. 11Well No. 1 Wilson Farm

Company


~~Fraser Oil~~  
Cross Oil250 Ft. from N. Line

Ft. from S. Line

Ft. from E. Line

250 Ft. from W. Line

NORTH

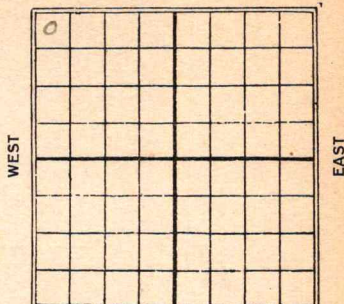

SOUTH

Date

REPORT

1925  
5/29

Location

4/5

6/12

6/19

6/26

7/3

7/10

7/17

7/24

7/31

8/7

8/14

8/20

8/27

9/3

9/11

9/16

9/24

10/1

10/8

900

5/0 900'



10/16 Jay Linn 1903 10/19 @ 1918

10/22

10/29 same

11/6 ———

11/13 ———

12/3- Abandoned 2218

Map No. 1842 Sec. 27 Twp. 25 R. 11Well No. 1 Fisher and Co. Company

Contractor

## FIRST REPORTS

## SECTION PLAT

250 Ft. from N. Line

Ft. from S. Line

Ft. from E. Line

250 Ft. from W. Line

|   |  |  |  |
|---|--|--|--|
| 0 |  |  |  |
|   |  |  |  |
|   |  |  |  |
|   |  |  |  |

Location ☒

Rig up

Drilling and Remarks:

## RECORD

Cased \_\_\_\_\_ in., \_\_\_\_\_ ft.

Sand \_\_\_\_\_

Gas \_\_\_\_\_

Oil \_\_\_\_\_

Total Depth \_\_\_\_\_

## PRODUCTION

1st 24 hrs. Nat. \_\_\_\_\_

1st 24 hrs. after shot \_\_\_\_\_

Gas \_\_\_\_\_ Cu. Ft.

Dry Hole \_\_\_\_\_

Abandoned \_\_\_\_\_

Date

MAY 29 1925

CHAS. L. SHERWOOD

Scout



Map No. 161 Sub 27 Sec. 25 Twp. 11 R. 11Well No. 1 WilsonClass and Co Company

Contractor

## SECTION PLAT

|   |  |  |  |
|---|--|--|--|
| 0 |  |  |  |
|   |  |  |  |
|   |  |  |  |
|   |  |  |  |
|   |  |  |  |

250 Ft. from N. Line

Ft. from S. Line

Ft. from E. Line

250 Ft. from W. Line

## CORRECTION

Location

Rig up

Drilling and Remarks:

"Machine"  
 Rigging up

Chg Ownership to  
 above

## RECORD

Cased \_\_\_\_\_ in., \_\_\_\_\_ ft.

Sand \_\_\_\_\_

Gas \_\_\_\_\_

Oil \_\_\_\_\_

Total Depth \_\_\_\_\_

## PRODUCTION

1st 24 hrs. Nat. \_\_\_\_\_

1st 24 hrs. after shot \_\_\_\_\_

Gas \_\_\_\_\_ Cu. Ft.

Dry Hole \_\_\_\_\_

Abandoned \_\_\_\_\_

Date

JUN 26 1925

CHAS. L. SHERWOOD

Scout

Map No. KANSAS 16 27 Sec. 25 Twp. 25 R. 11Well No. 1 WeldonCross Oil Co Company

Contractor

## COMPLETED

## SECTION PLAT

250 Ft. from N. Line

Ft. from S. Line

Ft. from E. Line

250 Ft. from W. Line

## ABANDONED

|   |  |  |  |
|---|--|--|--|
| 0 |  |  |  |
|   |  |  |  |
|   |  |  |  |
|   |  |  |  |

Location

Rig up

Drilling and Remarks:

Top line 2179'Dry & cho2. D. 2218'

## RECORD

Cased \_\_\_\_\_ in., \_\_\_\_\_ ft.

Sand \_\_\_\_\_

Gas \_\_\_\_\_

Oil \_\_\_\_\_

Total Depth 2218'

## PRODUCTION

1st 24 hrs. Nat. \_\_\_\_\_

1st 24 hrs. after shot \_\_\_\_\_

Gas \_\_\_\_\_ Cu. Ft.

Dry Hole ☒Abandoned ☒

Date

DEC 3 1925

CHAS. L. SHERWOOD

192

Scout