FORM 51 25M 8-50 WESTERN


Butler

KANSAS

Section 32 Township 24 Range 4E

Well No. #4 O. E. Moore

Company R. J. Wixson

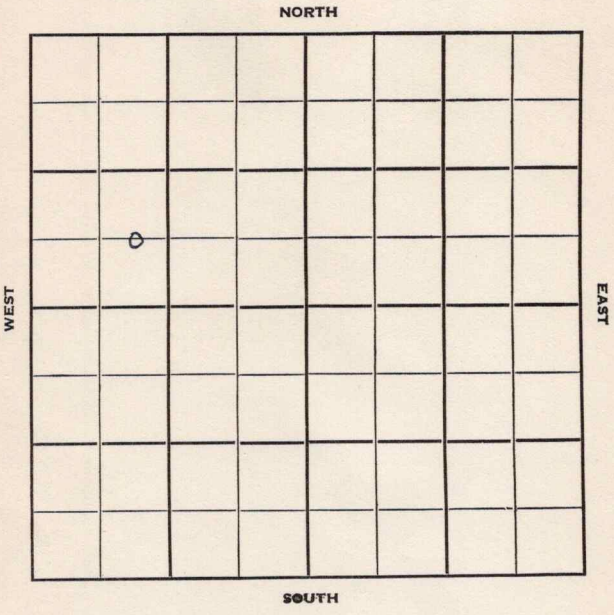

FORM 252-B
10M 10-50 PETROL

Butler Kansas

Sec. 32 Twp. 24 R. 4E

Well No. #4 O. E. Moore Farm

R. J. Wixson Company

Contractor

Potwin Pool


Ft. from N. Line

660' Ft. from S. Line

Ft. from E. Line

990' Ft. from W. Line

C E L SW NW

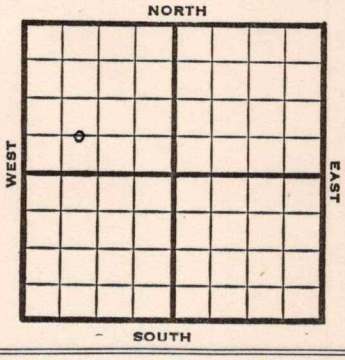

1951	Elev. 1346' REPORT
2/7	Spud 2-4-51 Drlg. 100'
3/7	Oil well TD 2711 15" @ 122 10" @ 1235 8" @ 2095 KC 2217 Cong. 2660 Miss. 2699 5" @ 2700 TD 2711 1000 A Comp. 15 bopd COMPLETED

FORM 275 FOR SALE BY KANSAS BLUE PRINT CO.

County Butler State Kansas

Sec. 32 (Blk. Twp.) 24 (Sur. Rge.) 4E Map No.

Operator R. J. Wixson

Well No. 4 Farm O. E. Moore

Elev. Location C E L SW NW



660 Ft. From S Line NW

990 Ft. From W Line Quarter

1st. Report FEB 7 1951

Completion

Remarks

Spudding Date 2-4-51

Drlg. Data Potwin Pool

drlg. 100

J. E. TYRA

FORM 275 FOR SALE BY KANSAS BLUE PRINT CO.


County Butler State Kansas

Sec. 32 (Blk. Twp.) 24 (Sur. Rge.) 4E Map No.

Operator R. J. Wixson

Well No. 4 Farm O. E. Moore

Elev. 1346 Location C E L SW NW

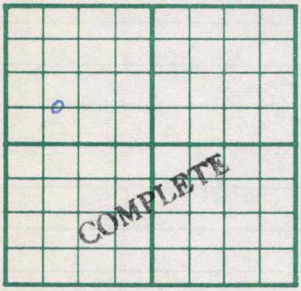

660 Ft. From S Line NW

990 Ft. From W Line Quarter

1st. Report

Completion MAR 7 1951

Remarks Potwin Pool

Spudding Date

Drlg. Data Oil well TD 2711

15" @ 122 10" @ 1235 8" @ 2095

KC 2217 Cong. 2660 Miss. 2699

5" @ 2700 TD 2711 1000 A

Comp. 15 bopd

J. E. TYRA