


Map No. _____ Sec. 9 Twp. 25 R. 11Well No. 3 R.H. Christy Farm _____Kons. - Sist Company _____

NORTH

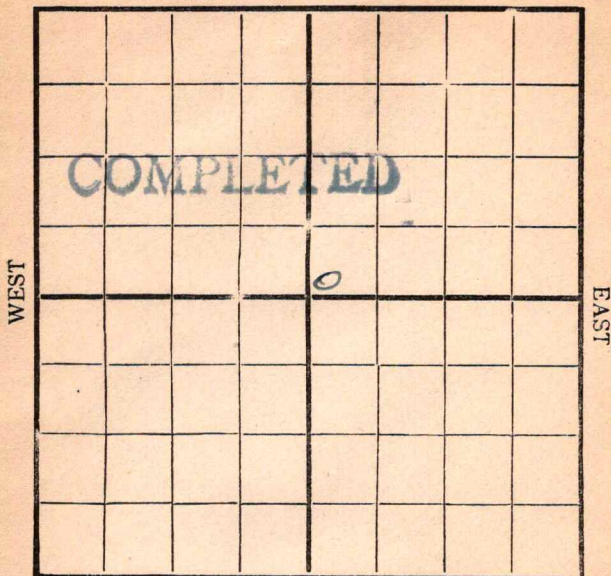

SOUTH

Location _____

Rig Up _____

Drilling Remarks:

Drilling Remarks:

RECORD

Cased _____ in _____ Ft.

Sand _____

Gas _____

Oil _____

Total Depth _____

PRODUCTION

1st 24 hrs. Nat. _____

1st 24 hrs. after shot _____

Gas _____ Cu. Ft.

Dry Hole _____

Abandoned _____


Greenwood

Map No. *K16* Sec. *9* Twp. *25* R. *11*

Well No. *3 R.H. Christy* Farm

Kans. Dist. Company

NORTH

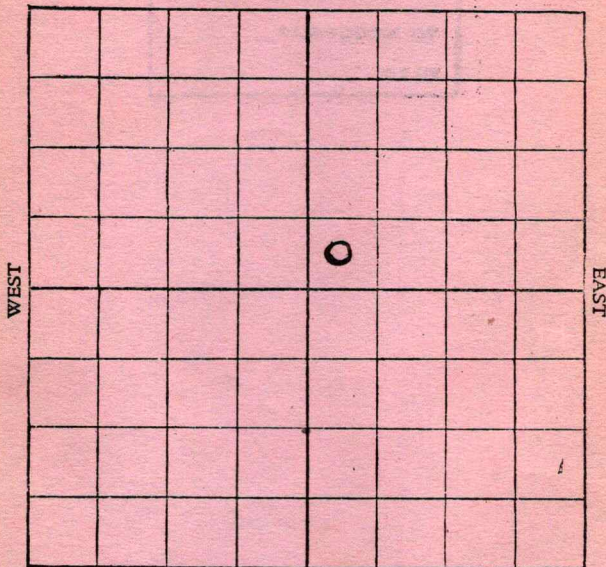

SOUTH

Location _____

Rig up _____

Drilling and remarks:

Rig up

RECORD

Cased _____ in. _____ Ft.

Sand _____

Gas _____

Oil _____

Total Depth _____

PRODUCTION

1st 24 hrs. Nat. _____

1st 24 hrs. after shot _____

Gas _____ Cu. Ft.

Dry Hole _____


Abandoned _____

Date

5/12, 191*7*, *Crocker* Scout

*Greenwood*Map No. _____ Sec. *9* Twp. *25* R. *11*Well No. *3 R. H. Christy* Farm*Kans. Dist.* Company

NORTH

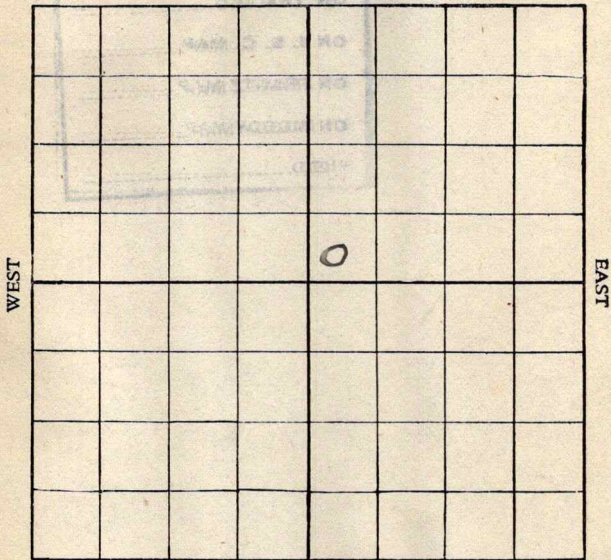

SOUTH

Location _____

Rig up _____

Drilling and remarks:

Rig up

RECORD

Cased _____ in. _____ Ft.

Sand _____

Gas _____

Oil _____

Total Depth _____

PRODUCTION

1st 24 hrs. Nat. _____

1st 24 hrs. after shot _____

Gas _____ Cu. Ft.

Dry Hole _____

Abandoned _____

Date

5/19, 191*7*, *Crocker* Scout


Greenwood

Map No. _____ Sec. 9 Twp. 25 R. 11Well No. 3 R. H. Christy Farm __________ Ks. Dist. Company _____

NORTH

WEST

EAST

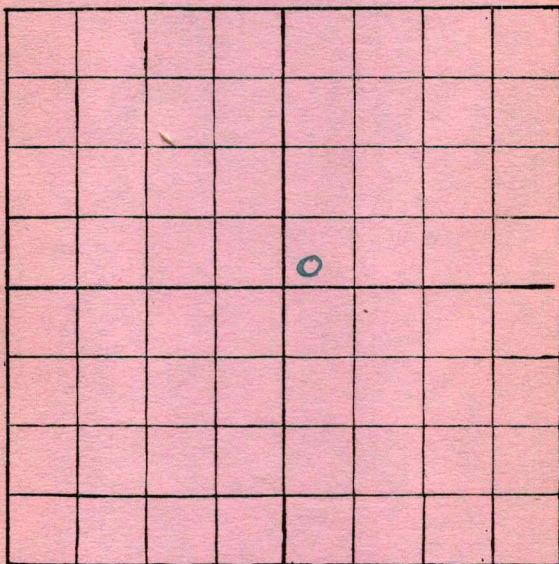

SOUTH

Location _____

Rig up _____

Drilling and remarks:

Rig.

RECORD

Cased _____ in. _____ Ft.

Sand _____

Gas _____

Oil _____

Total Depth _____

PRODUCTION

1st 24 hrs. Nat. _____

1st 24 hrs. after shot _____

Gas _____ Cu. Ft.

Dry Hole _____


Abandoned _____

Date

5/26, 1917, Crocker Scout

Map No. _____ Sec. 9 Twp. 25 R. 11
 Well No. 3 R. H. Christy Farm _____
Kans. Dist. Company _____

NORTH

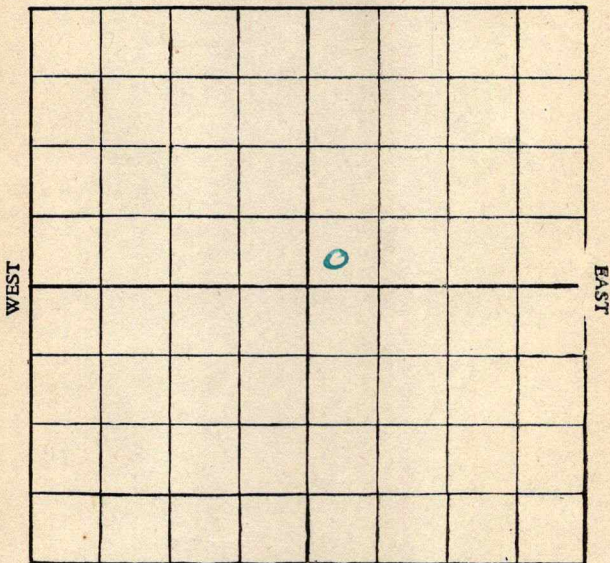

SOUTH

Location _____

Rig up _____

Drilling and remarks:

Rig

RECORD

Cased _____ in. _____ Ft.

Sand _____

Gas _____

Oil _____

Total Depth _____

PRODUCTION

1st 24 hrs. Nat. _____

1st 24 hrs. after shot _____

Gas _____ Cu. Ft.

Dry Hole _____

Abandoned _____


Date

6/2, 1917, Brocker Scout

Greenwood

Map No. _____ Sec. 9 Twp. 25 R. 11Well No. 3 R. H. Christy FarmKans.-Dist. Company

NORTH

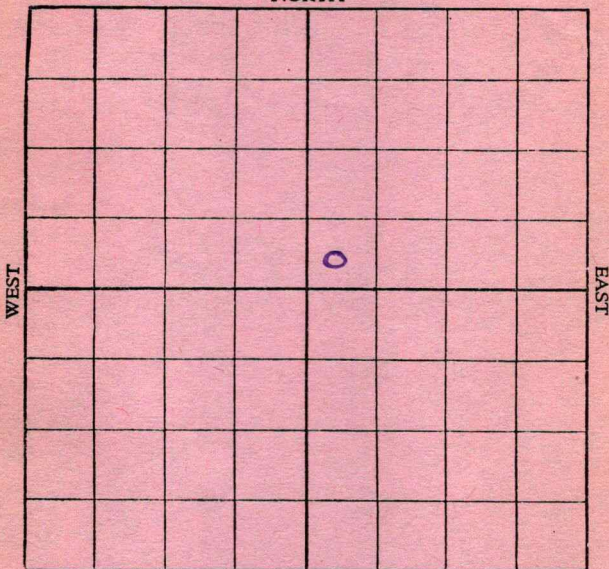

SOUTH

Location _____

Rig up _____

Drilling and remarks:

Rign up

RECORD

Cased _____ in. _____ Ft.

Sand _____

Gas _____

Oil _____

Total Depth _____

PRODUCTION

1st 24 hrs. Nat. _____

1st 24 hrs. after shot _____

Gas _____ Cu. Ft.

Dry Hole _____

Abandoned _____

Date

JUN 9 - 1917

C. T. Crocker

, 191


Scout

Greenwood

Map No. _____ Sec. 9 Twp. 25 R. 11Well No. 3 R.H. Christy Farm __________Ks. Dist._____
Company _____

NORTH

WEST

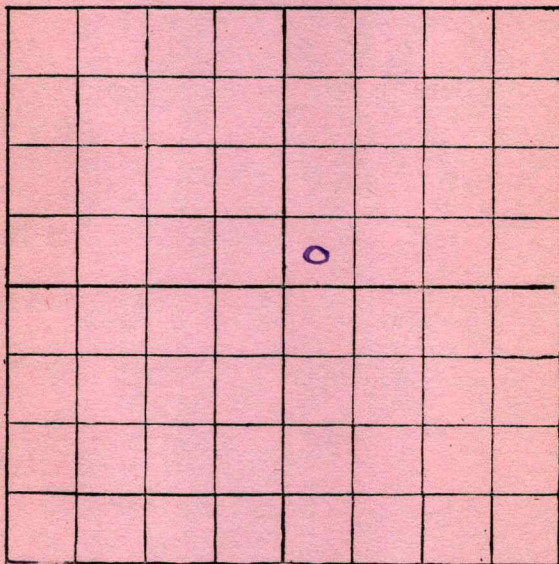

EAST

SOUTH

Location _____

Rig up _____

Drilling and remarks:

RECORD

Cased _____ in. _____ Ft.

Sand _____

Gas _____

Oil _____

Total Depth _____

PRODUCTION

1st 24 hrs. Nat. _____

1st 24 hrs. after shot _____

Gas _____ Cu. Ft.

Dry Hole _____

Abandoned _____

Date


JUN 16 1917

_____, 191_____, _____ Scout

C. J. Crocker

Map No. _____ Sec. 9 Twp. 25 R. 11Well No. 3 R. H. Christy FarmKs. - Dist Company

NORTH

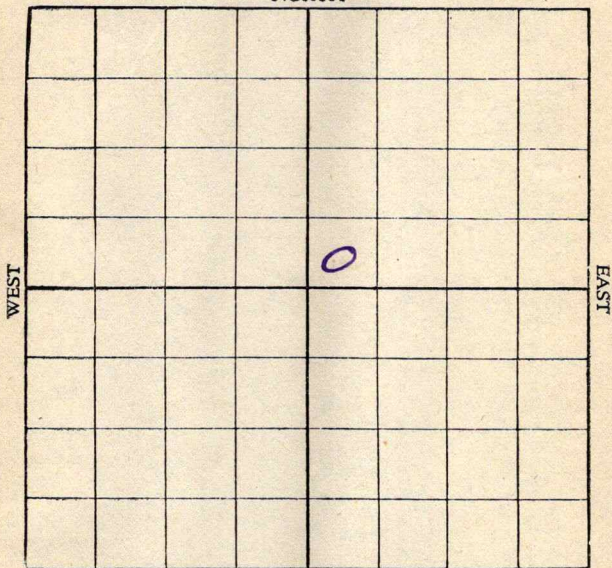

SOUTH

Location _____

Rig up _____

Drilling and remarks:

D-200'

RECORD

Cased _____ in. _____ Ft.

Sand _____

Gas _____

Oil _____

Total Depth _____

PRODUCTION

1st 24 hrs, Nat. _____

1st 24 hrs, after shot _____

Gas _____ Cu, Ft.

Dry Hole _____

Abandoned _____

Date

JUN 22 1917

191


E. J. Crocker.
Scout

gun road

Map No. _____ Sec. *9* Twp. *25* R. *11*

Well No. *3* *R. H. Christy* Farm

NORTH

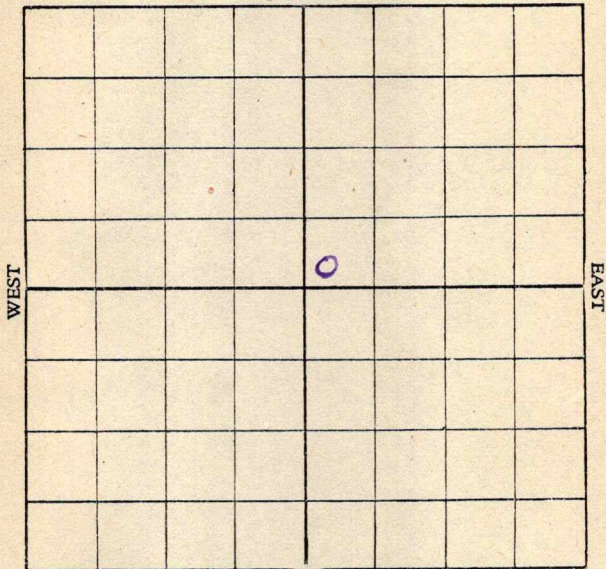

SOUTH

Location _____

Rig up _____

Drilling and remarks:

5-400

RECORD

Cased _____ in. _____ Ft.

Sand _____

Gas _____

Oil _____

Total Depth _____

PRODUCTION

1st 24 hrs. Nat. _____

1st 24 hrs. after shot _____

Gas _____ Cu. Ft.

Dry Hole _____

Abandoned _____

Date *JUN 30 1917*

G. T. Crook Scout

, 191

Greenwood

Map No. _____ Sec. *9* Twp. *25* R. *11*
 Well No. *3 R. H. Christy* Farm
Kans - Dist Company

NORTH

WEST

EAST

SOUTH

Location _____

Rig up _____

Drilling and remarks:

S.D. 450'

RECORD

Cased _____ in. _____ Ft.

Sand _____

Gas _____

Oil _____

Total Depth _____

PRODUCTION

1st 24 hrs. Nat. _____

1st 24 hrs. after shot _____

Gas _____ Cu. Ft.

Dry Hole _____

Abandoned _____

Date


JUL 7 1917, 191

E. J. Crocker
 Scout

Map No. _____ Sec. *9* Twp. *25* R. *11*

Well No. *3* *R.H. Christy* Farm
Kansas Dist. Company

NORTH

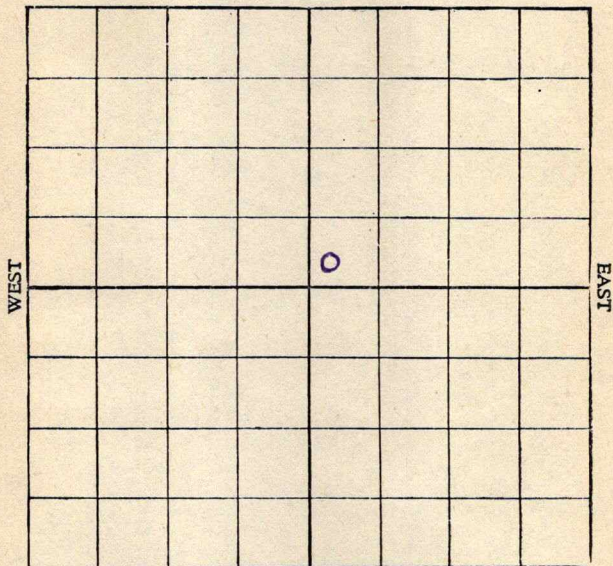

SOUTH

Location _____

Rig up _____

Drilling and remarks:

R.D. - 450

RECORD

Cased _____ in. _____ Ft.

Sand _____

Gas _____

Oil _____

Total Depth _____

PRODUCTION

1st 24 hrs. Nat. _____

1st 24 hrs. after shot _____

Gas _____ Cu. Ft.

Dry Hole _____

Abandoned _____

Date

JUL 14 1917

C. J. Crockett Scout


Map No. _____ Sec. 9 Twp. 25 R. 11

Well No. 30 Christ Farm _____

Kansas Drilling Company

NORTH

WEST

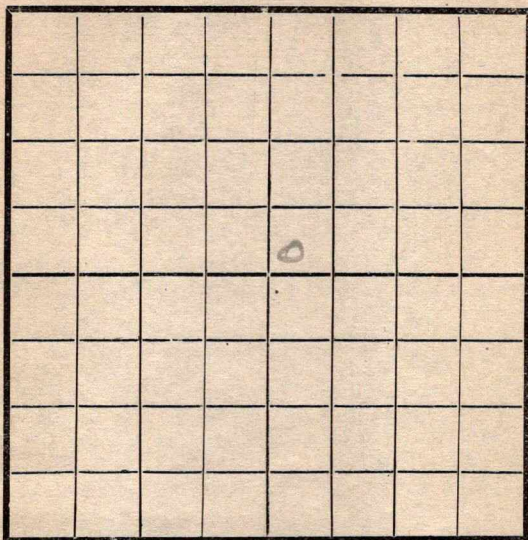

EAST

SOUTH

Location _____

Rig Up _____

Drilling and remarks

600

RECORD

Cased _____ in. _____ Ft.

Sand _____

Gas _____

Oil _____

Total Depth _____

PRODUCTION

1st 24 hrs. Nat. _____

1st 24 hrs. after shot _____

Gas _____ Cu. Ft.

Dry Hole _____


Abandoned _____

Date

7/17/1917 Landry Scout

Map No. **K16** Sec. **9** Twp. **25** R. **11**
 Well No. **3. Christy** Farm
Empire Company
Greenwood NORTH

WEST

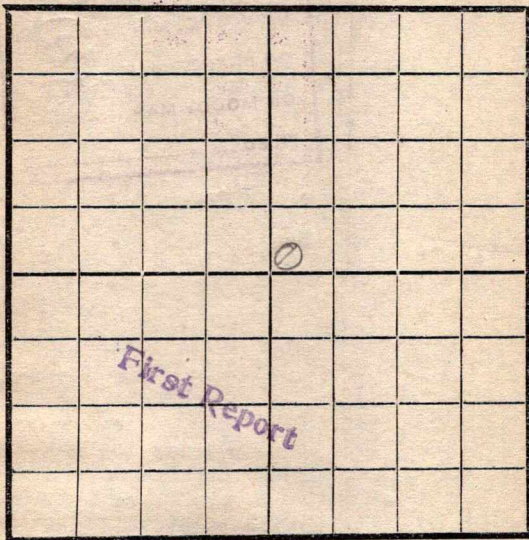

EAST

SOUTH

Location -----

Rig Up -----

Drilling and remarks

at 1650

RECORD

Cased ----- in. ----- Ft.

Sand -----

Gas -----

Oil -----

Total Depth -----

PRODUCTION

1st 24 hrs. Nat. -----

1st 24 hrs. after shot -----

Gas ----- Cu. Ft.

Dry Hole -----

Abandoned -----


Date

8-31, 1917 *Rautz* Scout


NORTH

WEST

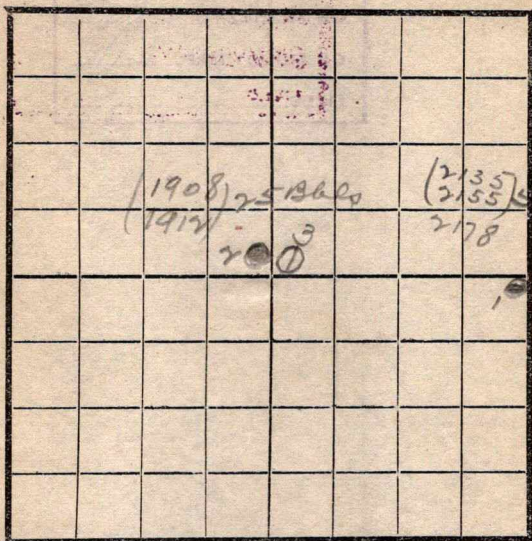

EAST

SOUTH

Location -----

Rig Up -----

Drilling and remarks

at 1600

RECORD

Cased ----- in. ----- Ft.

Sand -----

Gas -----

Oil -----

Total Depth -----

PRODUCTION

1st 24 hrs. Nat. 25 Bales

1st 24 hrs. after shot -----

Gas ----- Cu. Ft.

Dry Hole -----

Abandoned -----

Date


9-5, 1917 Rantz Scout

Map No. _____ Sec. 9 Twp. 25 R. 11Well No. 3 Christy Farm _____Empire Company _____

NORTH

WEST

EAST

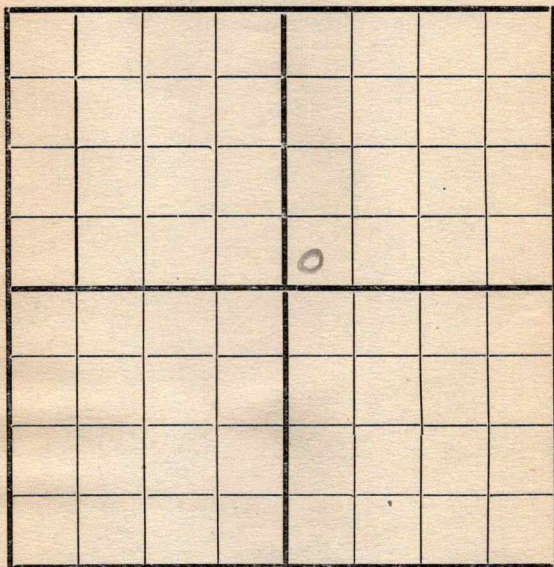

SOUTH

Location _____

Rig Up _____

Drilling and remarks

Drilling at
1810"
Missed
getting sand

RECORD

Cased _____ in. _____ Ft.

Sand _____

Gas _____

Oil _____

Total Depth _____

PRODUCTION

1st 24 hrs. Nat. _____

1st 24 hrs. after shot _____

Gas _____ Cu. Ft.

Dry Hole _____

Abandoned _____

Date


7/14 1917 Candys Scout

Map No. _____ Sec. 9 Twp. 25 R. 11Well No. 30 Christy Farm _____

Company _____

NORTH

WEST

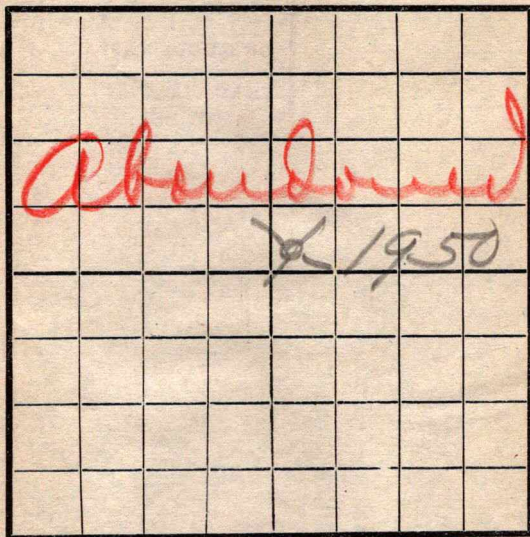

EAST

SOUTH

RECORD

Location _____

Cased _____ in. _____ Ft.

Rig Up _____

Sand _____

Drilling and remarks

Gas _____

Oil _____

Total Depth _____

PRODUCTION

1st 24 hrs. Nat. _____

1st 24 hrs. after shot _____

Gas _____ Cu. Ft.

Dry Hole _____

Abandoned _____

Date

9/27, 191 7 Carding Scout

(Greenwood Co)