
FORM 51 10M 12-46 PETROL KANSAS Butler county

Section 32 Township 24 Range 4-E

Well No. #2, Moore

Company Ralph Wixson

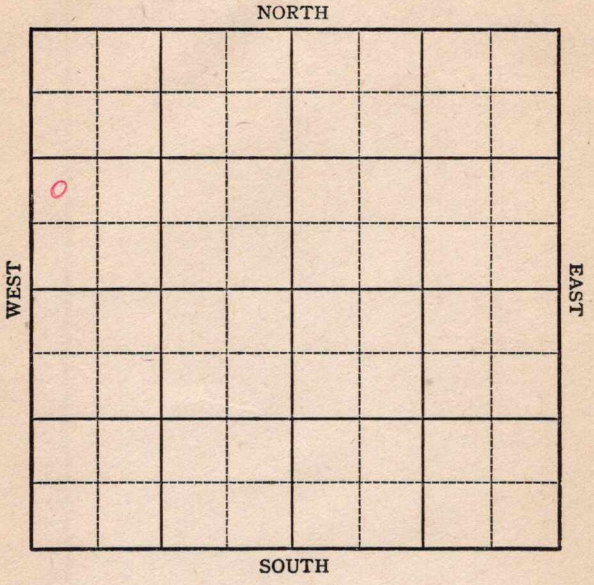

FORM 252-A
5M 6-46 PETROL

KANSAS

Butler county

Sec. 32 Twp. 24 R. 4-E

Well No. #2, Moore Farm

Ralph Wixson Company

Miscellaneous


____ Ft. from N. Line

990' Ft. from S. Line

____ Ft. from E. Line

330' Ft. from W. Line

NW SW NW

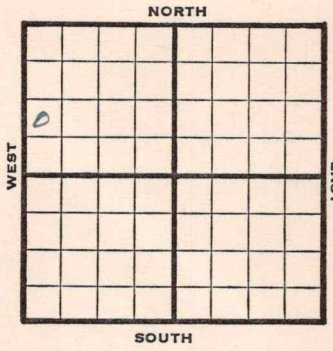

	REPORT
1946	Elev. 1336'
12/4	Spud
12/10	1130 Run csg.
12/17	10" @ 1165' Drlg 2095'
1947	
1/2	Miss 2679' 5" @ 2679' TD 2692' Pump 10 POT 38 Grav.

COMPLETED

Form 26 200 Bks. 10-46 Petrol Kansas KANSAS Miscellaneous

Map No. 14 Sec. 32 Twp. 24 R. 4E


Well No. 2 Moore

Ralph Wixson Company

FIRST REPORT Contractor

NW SW NW

SECTION PLAT

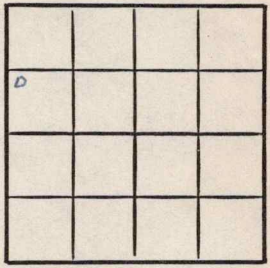

Ft. from N. Line

990 Ft. from S. Line

Ft. from E. Line

330 Ft. from W. Line

Butler County

Location

Rig up

Drilling and Remarks:

Spud

RECORD

Cased in., ft.

Sand

Gas

Oil

Total Depth

PRODUCTION

1st 24 hrs. Nat.

1st 24 hrs. after shot

Gas Cu. Ft.

Dry Hole

Abandoned

Date

DEC 4 1946 19 S. J. LEWIS Scout

Form 26 200 Bks. 10-46 Petrol Kansas KANSAS Miscellaneous

Map No. 14 Sec. 32 Twp. 24 R. 4E


Well No. 2 Moore

Ralph Wixson Company

COMPLETED Contractor

NW SW NW E 1,1386

SECTION PLAT

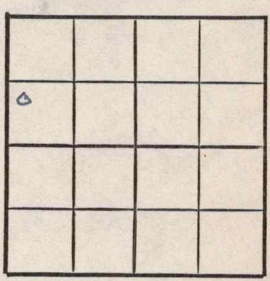

Ft. from N. Line

990 Ft. from S. Line

Ft. from E. Line

330 Ft. from W. Line

Butler County

Location

Rig up

Drilling and Remarks:

Miss 2679

5" @ 2679

Pump 10 Bbl

85 gr

RECORD

Cased in., ft.

Sand

Gas

Oil

Total Depth 2692

PRODUCTION

1st 24 hrs. Nat.

1st 24 hrs. after shot

Gas Cu. Ft.

Dry Hole

Abandoned

Date

JAN 2 1947 19 S. J. LEWIS Scout