


Kansas ✓

Map No. _____ Sec. 11 Twp. 25 R. 11Well No. 1 - Deets Farm _____Callahan & Ainsworth Company

NORTH

WEST

EAST

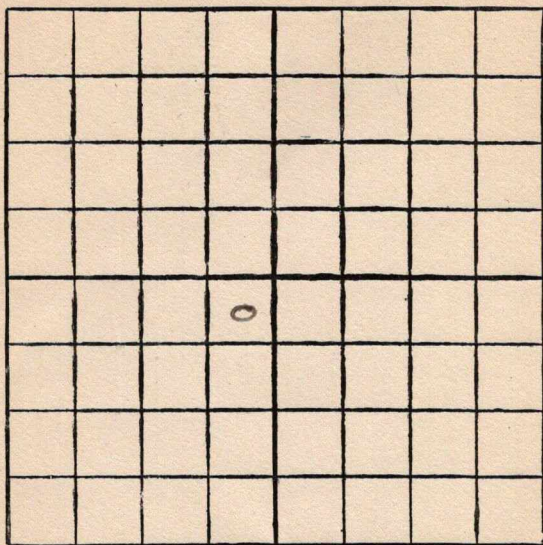

SOUTH

Location

Drilling Remarks

Rig Up

Drilling Remarks

RECORD

Cased in. ft.

Sand

Gas

Oil

Total Depth

PRODUCTION

1st 24 hrs. Nat.

1st 24 hrs. after shot

Gas cu. ft.

Dry Hole


Abandoned

Map No. _____ Sec. 11 Twp. 25 R. 11Well No. 1- Seets Farm
Callahan & Ainsworth Company330 Ft. from N. Line

_____ Ft. from S. Line

330 Ft. from E. Line

_____ Ft. from W. Line

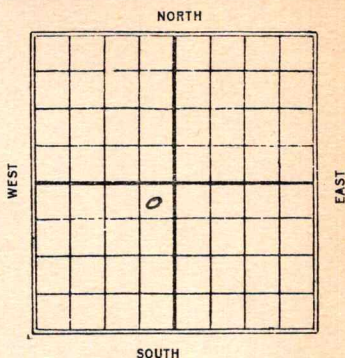1921

Date

REPORT

2/16 Location2/24 _____3/2 _____3/9 _____3/16 _____3/24 _____3/30 _____4/7 Machine - Rigging up4/13 Spudding4/20 Spudded to S.D.4/27 Drlg 5005/5 S.D. 8005/12 S.D. 11655/18 _____5/25 _____6/1 _____6/7 _____6/15 _____6/22 S.D. 14056/29 _____7/7 _____7/13 W.R. 1740'

7/20 - Top line 1838
1st break 1850-60
D. & A. 1860

16 **KANSAS** Sec. 11 Twp. 25 R. 11
 Map No. _____
 Well No. 1 See to

Callahan & Hinckworth Company

Contractor

FIRST REPORTS

SECTION PLAT

330 Ft. from N. Line

Ft. from S. Line

330 Ft. from E. Line

Ft. from W. Line

	o		

Location ✓

Rig up

Drilling and Remarks:

RECORD

Cased _____ in., _____ ft.

Sand _____

Gas _____

Oil _____

Total Depth _____

PRODUCTION

1st 24 hrs. Nat. _____

1st 24 hrs. after shot _____

Gas _____ Cu. Ft.

Dry Hole _____

Abandoned _____

Date

FEB 16 1927

CHAS. L. SHERWOOD

192

Scout

16 **KANSAS** Sec. 11 Twp. 25 R. 11

Well No. 1 Deets

Callahan & Ainsworth Company

Contractor

COMPLETED

SECTION PLAT

330 Ft. from N. Line

Ft. from S. Line

330 Ft. from E. Line

Ft. from W. Line

ABANDONED

	0		

Location

Rig up

Drilling and Remarks:

Top line 1838'

1st Bx 1850-60

2nd 1860

RECORD

Cased in., ft.

Sand

Gas

Oil

Total Depth 1860

PRODUCTION

1st 24 hrs. Nat.

1st 24 hrs. after shot

Gas Cu. Ft.

Dry Hole ✓

Abandoned ✓

Date

JUL 20 1927

CHAS. L. SHERWOOD

192

Scout