
Form 51—10M—8-19—CroMac

Map No. K-23 Sec. 9 Twp. 22 R. 4

Well No. 4 Jolliffe Farm

~~Edmonds~~ Company

Orlando

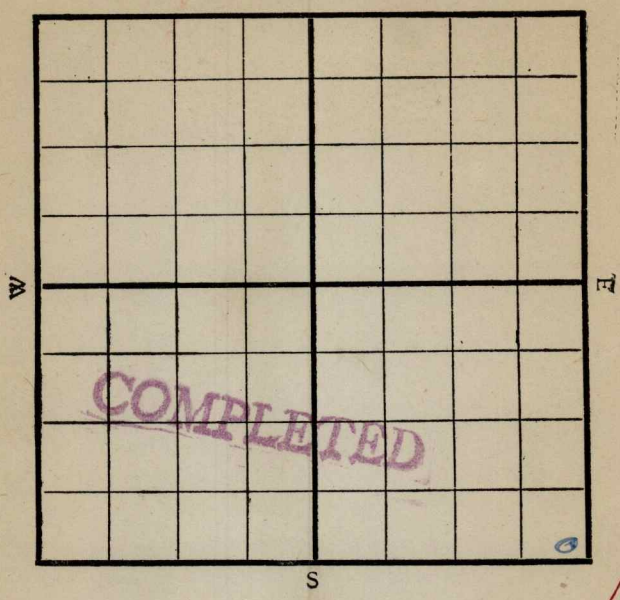

16

Location	Rig Up
Drilling Remarks:	Drilling Remarks:

RECORD		PRODUCTION	
Cased	in. ft.	1st 24 hrs. Nat.	
Sand		1st 24 hrs. after shot	
Gas		Gas	cu. ft.
Oil		Dry Hole	
Total Depth		Abandoned	

Form 252A 2M-9-19-CroMac.

Map No. _____ Sec. 9 Twp. 22 R. 4

Well No. 4 Jaliffe Farm

~~Elmhurst Oil~~ Company

Orlando Pet. Contractor


SE Quarter

_____ Ft. from N. Lice

200 Ft. from S. Line

200 Ft. from E. Line

_____ Ft. from W. Line

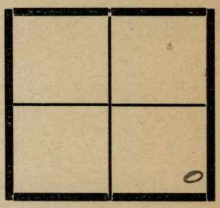

Date	REPORT
10/13	Rig
10/20	"
10-30	"
11/3	Tools
12	Tools
18	Drlg 4700
24	Drlg. 1100'.
12/1	10" 1760
7/8	SD. 1900 for water
15	Shut down 2050'
22	Shut Down 2050'
31	" " "
1/6/20	SD 2050'
14	U. R. 8½ to 2100'
19	SD 2100'
28	Dry & abandoned 2560'

Form 26—1M—4-19—Mid-West

Map No. K23 Sec. 9 Twp. 22 R. 4

Well No. 4 Sallisaw

Orlando Oil Company

Contractor

SECTION PLAT



200 Ft. from N. Line

200 Ft. from S. Line

200 Ft. from E. Line

Ft. from W. Line

CHANGE LESSEE NAM

Location

Rig up

Drilling and Remarks:

N. D@ 2050

RECORD

Cased in., ft.

Sand

Gas

Oil

Total Depth

PRODUCTION

1st 24 hrs. Nat.

1st 24 hrs. after shot

Gas Cu. Ft.

Dry Hole

Abandoned

Date

1/6 191 9.

Pyle Scout

Form 26—1M—4-19—Mid-West


Map No. K23 Sec. 9 Twp. 22 R. 4

Well No. 4 Sailliff

Orlando Oil Co. Company

Contractor

SECTION PLAT

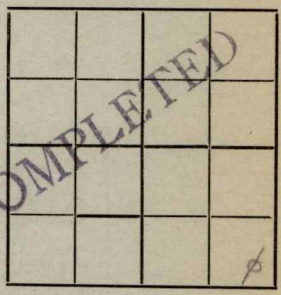

_____Ft. from N. Line

200 Ft. from S. Line

200 Ft. from E. Line

_____Ft. from W. Line

Location _____

Rig up _____

Drilling and Remarks:

RECORD

Cased _____in., _____ft.

Sand _____

Gas _____

Oil _____

Total Depth _____

PRODUCTION

1st 24 hrs. Nat. _____

1st 24 hrs. after shot _____

Gas _____ Cu. Ft.

Dry Hole 2550

Abandoned _____

Date

Jan 26 191____

Pyle Scout

Form 26—1M—4-19—Mid-West

Map No. K23 Sec. 9 Twp. 22 R. 4

Well No. 4 Talliaferro

Elmhurst Company

Contractor

SECTION PLAT



Ft. from N. Line

2000 Ft. from S. Line

2000 Ft. from E. Line

Ft. from W. Line

Location

Rig up

Drilling and Remarks:

RECORD

Cased in., ft.

Sand

Gas

Oil

Total Depth

PRODUCTION

1st 24 hrs. Nat.

1st 24 hrs. after shot

Gas Cu. Ft.

Dry Hole

Abandoned

Date

9/23/1919

Pyle Scout

Form 26—1M—4-19—Mid-West

Map No. K 23 Sec. 9 Twp. 22 R. 4

Well No. 4 Dolliff

Elmhurst Company

FIRST REPORT Contractor

SECTION PLAT



200 Ft. from N. Line

Ft. from S. Line

700 Ft. from E. Line

Ft. from W. Line

FIRST REPORT

Location

Rig up

Drilling and Remarks:

RECORD

Cased in., ft.

Sand

Gas

Oil

Total Depth

PRODUCTION

1st 24 hrs. Nat.

1st 24 hrs. after shot

Gas Cu. Ft.

Dry Hole

Abandoned

Date

9/29/191 9. Pyle Scout

Form 26—1M—4-19—Mid-West


Map No. K 23 Sec. 9 Twp. 22 R. 4

Well No. 4 Jacobs

Elmhurst Company

Contractor

SECTION PLAT

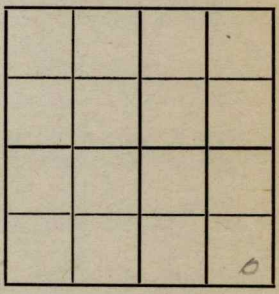

200 Ft. from S. Line

200 Ft. from E. Line

Ft. from N. Line

Ft. from W. Line

Location

Rig up

Drilling and Remarks:

RECORD

Cased in., ft.

Sand

Gas

Oil

Total Depth

PRODUCTION

1st 24 hrs. Nat.

1st 24 hrs. after shot

Gas Cu. Ft.

Dry Hole

Abandoned

Date

10/6 191 9. Pyle Scout

Form 26—1M—4-19—Mid-West


Map No. K23 Sec. 9 Twp. 22 R. 4

Well No. 4 Jolliffe

Elmhurst Company

Contractor

SECTION PLAT

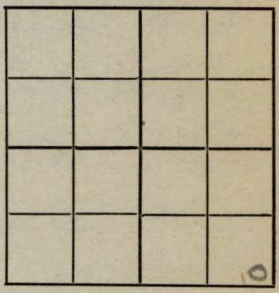

Ft. from N. Line

200 Ft. from S. Line

200 Ft. from E. Line

Ft. from W. Line

Location

Rig up

Drilling and Remarks:

Rig

RECORD

Cased in., ft.

Sand

Gas

Oil

Total Depth

PRODUCTION

1st 24 hrs. Nat.

1st 24 hrs. after shot

Gas Cu. Ft.

Dry Hole

Abandoned

Date

10/13 1919

Pyle Scout

Form 26—1M—4-19—Mid-West


Map No. K23 Sec. 9 Twp. 22 R. 4

Well No. 4 Dalliffe

Elmhurst Company

Contractor

SECTION PLAT

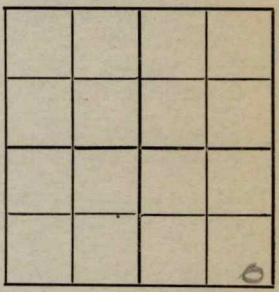

Ft. from N. Line

200 Ft. from S. Line

200 Ft. from E. Line

Ft. from W. Line

Location

Rig up

Drilling and Remarks:

RECORD

Cased in., ft.

Sand

Gas

Oil

Total Depth

PRODUCTION

1st 24 hrs. Nat.

1st 24 hrs. after shot

Gas Cu. Ft.

Dry Hole

Abandoned

Date

10/20 191 9

Pyle Scout

FORM 26 250 BKS. 4-28 WESTERN


MAP NO. _____ SEC. 9 TWP. 22S R. 4E

WELL NO. 4 Dillis

E M Kurtz Inv COMPANY

_____ CONTRACTOR

SECTION PLAT

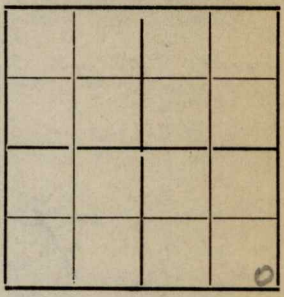

_____ FT. FROM N. LINE

_____ FT. FROM S. LINE

_____ FT. FROM E. LINE

_____ FT. FROM W. LINE

LOCATION _____

RIG UP _____

DRILLING AND REMARKS:

RECORD

CASED _____ IN., _____ FT.

SAND _____

GAS _____

OIL _____

TOTAL DEPTH 2550

PRODUCTION

1ST 24 HRS. NAT. _____

1ST 24 HRS. AFTER SHOT _____

GAS _____ CU. FT.

DRY HOLE ✓

ABANDONED _____

DATE 1/16 192 0 _____ SCOUT