

Map No. \_\_\_\_\_ Sec. 9 Twp. 25 R. 11  
 Well No. 1 Christy Farm  
Emerald Oil Company

NORTH

WEST

EAST



SOUTH

Location \_\_\_\_\_

Rig Up \_\_\_\_\_

Drilling Remarks:

Drilling Remarks:

\_\_\_\_\_  
 \_\_\_\_\_  
## RECORD

Cased \_\_\_\_\_ in. \_\_\_\_\_ ft.

Sand \_\_\_\_\_

Gas \_\_\_\_\_

Oil \_\_\_\_\_

Total Depth \_\_\_\_\_

## PRODUCTION

1st 24 hrs. Nat. \_\_\_\_\_

1st 24 hrs. after shot \_\_\_\_\_

Gas \_\_\_\_\_ cu. ft.

Dry Hole \_\_\_\_\_

Abandoned \_\_\_\_\_


Map No. \_\_\_\_\_ Sec. 9 Twp. 25 R. 11Well No. J. Christy Farm \_\_\_\_\_Emerald Oil Co Company \_\_\_\_\_Contractor SE \_\_\_\_\_

Quarter \_\_\_\_\_

\_\_\_\_\_ Ft. from N. Line

1090 Ft. from S. Line

\_\_\_\_\_ Ft. from E. Line

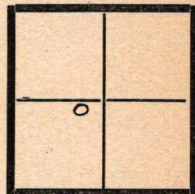990 Ft. from W. Line

REPORT

FIRST REPORT

~~10/16~~

8/21

Dry 500'

10/29

SP. 1650'

11/7


Dry 1700'

17/6

Dry abandoned 1720'

Map No. K 16 Sec. 9 Twp. 25 R. 11  
 Well No. 8 Christy Farm  
Emerald Oil Company

NORTH

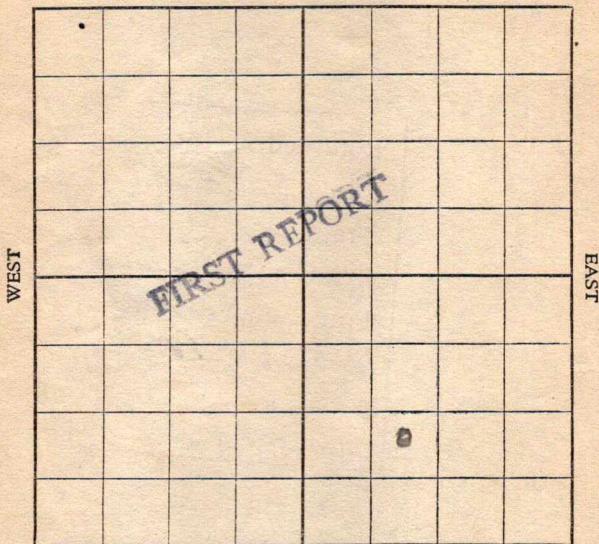

990 W

SOUTH

1020 S

Location .....

Rig up .....

Drilling and Remarks:

500'

## RECORD

Cased ..... in. .... Ft.

Sand .....

Gas .....

Oil .....

Total Depth .....

## PRODUCTION

1st 24 hrs. Nat. ....

1st 24 hrs. after shot .....

Gas ..... Cu. Ft.

Dry Hole .....

Abandoned .....

Date

8/21

, 1919,

Py h

Scout



Map No. K 16 Sec. 9 Twp. 25 R. 11Well No. 8 ChristyEmerald Oil Company

Contractor

## SECTION PLAT

Ft. from N. Line

1020 Ft. from S. Line

Ft. from E. Line

990 Ft. from W. Line

Location

Rig up

Drilling and Remarks:

## RECORD

Cased in, ft.

Sand

Gas

Oil

Total Depth

## PRODUCTION

1st 24 hrs. Nat.

1st 24 hrs. after shot

Gas / Cu. Ft.

Dry Hole 1720

Abandoned

Date

12/6 1919

Pyle

Scout