


Map No. KANSAS Sec. 15 Twp. 25 R. 11 E

Well No. 1 Brather Farm
McGinnis Company

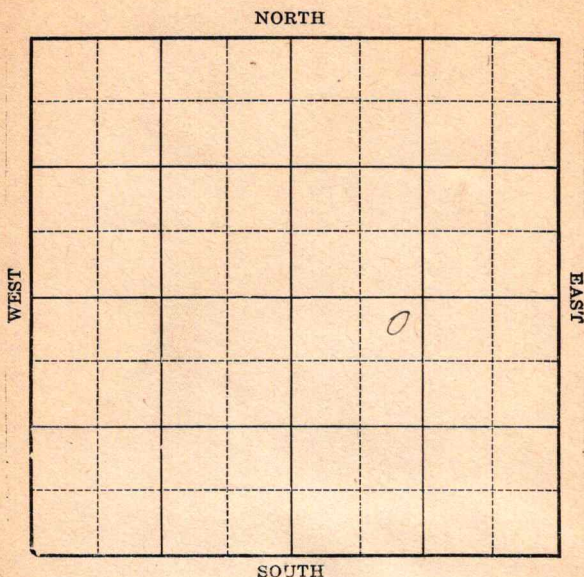

Location _____

Drilling Remarks _____

Rig Up _____

Drilling Remarks _____

RECORD

Cased _____ in. _____ ft.

Sand _____

Gas _____

Oil _____

Total Depth _____

PRODUCTION

1st 24 hrs. Nat. _____

1st 24 hrs. after shot _____

Gas _____ cu. ft.

Dry Hole _____

Abandoned _____

Greenwood

Map No. Sec. 15 Twp. 25 R. 11 E


Well No. 1 *Prather* Farm
Mc Ginnis Company

250' Ft. from N. Line

 Ft. from S. Line

 Ft. from E. Line

1070' Ft. from W. Line

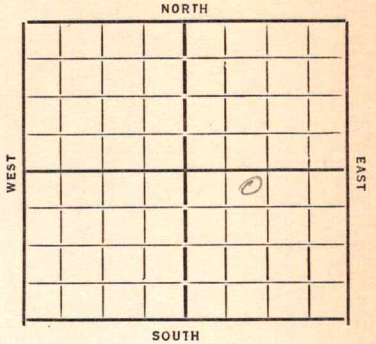

Date 1933

REPORT

12/13 *Machine*

12/27 *Drill 790*

1/11 *6" at 1667*

1/17 *Sand 1670-83-1500' oil*

1/24 *Sand 1670-83*
50 bbls

COMPLETED

Map No. 16 Sec. 15 Twp. 25 R. 11 E

Well No. 1-Prather

McKinnis

FIRST REPORTS

Company

Contractor

SECTION PLAT

250 Ft. from N. Line
 _____ Ft. from S. Line
 _____ Ft. from E. Line
1070 Ft. from W. Line

		o	

Location _____

Rig up _____

Drilling and Remarks:

machine

RECORD

Cased _____ in., _____ ft.
 Sand _____
 Gas _____
 Oil _____
 Total Depth _____

PRODUCTION

1st 24 hrs. Nat. _____
 1st 24 hrs. after shot _____
 Gas _____ Cu. Ft.
 Dry Hole _____
 Abandoned _____

Date

12-13-33 192 O. W. Mammick Scout

Map No. 16 Sec. 15 Twp. 25 R. 11E

Well No. 1-prather

McGinnis Company

Contractor

COMPLETED

SECTION PLAT

		0	

250 Ft. from N. Line

..... Ft. from S. Line

..... Ft. from E. Line

1070 Ft. from W. Line

Location.....

Rig up.....

Drilling and Remarks:

50 bbls

RECORD

Cased.....in.,.....ft.

Sand 1670-83

Gas.....

Oil.....

Total Depth 1683

PRODUCTION

1st 24 hrs. Nat.....

1st 24 hrs. after shot.....

Gas.....Cu. Ft.

Dry Hole.....

Abandoned.....

Date

1-24-34 192 C. Mannesbach Scout