


Greenwood

Form 51-5M-11-31-Palace

Map No. **KANSAS** Sec. *15* Twp. *25* R. *11E*

Well No. *1 Smith* Farm
Mc Ginnis Company

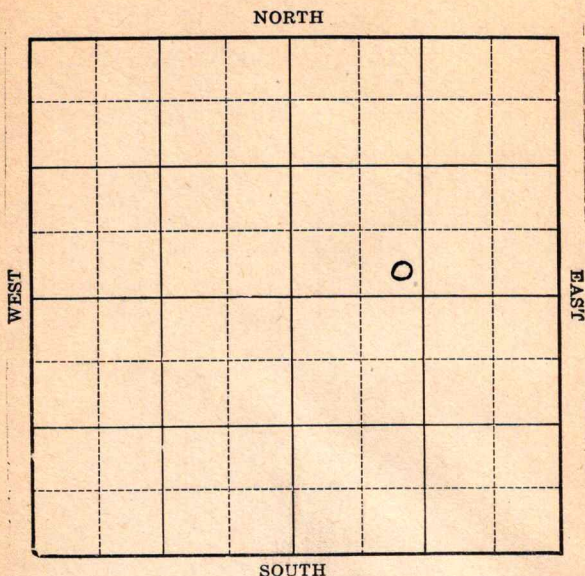

Location _____

Drilling Remarks _____

Rig Up _____

Drilling Remarks _____

RECORD

Cased _____ in. _____ ft.

Sand _____

Gas _____

Oil _____

Total Depth _____

PRODUCTION

1st 24 hrs. Nat. _____

1st 24 hrs. after shot _____

Gas _____ cu. ft.

Dry Hole _____

Abandoned _____

Greenwood

Form 252-A
5M 4-32 MPC

Map No. **KANSAS** Sec. 15 Twp. 25 R. 11 E

Well No. 1 Smith Farm


Mc Ginnis Company

 Ft. from N. Line

250 Ft. from S. Line

 Ft. from E. Line

1090 Ft. from W. Line

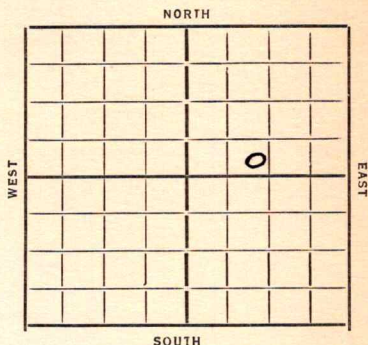

Date

REPORT

1934

3/7 Location

3/15 Location

3/22 — 3/29 —

4/5 Rign

4/12 Spud

4/19 SD 600

4/26 dly 925

5/3 " 1535

5/10 1641-76 HFW U. R. 6"

5/16 Sand 1640-73 TD 1676 D & A

ABANDONED

Map No. 16 Sec. 15 Twp. 25 R. 11 EWell No. 1- SmithMcGinnis Company

Contractor

SECTION PLAT

FIRST REPORTS

Ft. from N. Line

250 Ft. from S. Line

Ft. from E. Line

1070 Ft. from W. Line

		0	

Location ✓

Rig up

Drilling and Remarks:

RECORD

Cased.....in.,ft.

Sand.....

Gas.....

Oil.....

Total Depth.....

PRODUCTION

1st 24 hrs. Nat.....

1st 24 hrs. after shot.....

Gas.....Cu. Ft.

Dry Hole.....

Abandoned.....

Date

3-7-34 192 O. Mannuch Scout

KANSAS

Map No. 16 Sec. 15 Twp. 25 R. 11 EWell No. 1 - SmithMcGinnis

Company

Contractor

ABANDONED

SECTION PLAT

_____ Ft. from N. Line

250 Ft. from S. Line

_____ Ft. from E. Line

1070 Ft. from W. Line

Location _____

Rig up _____

Drilling and Remarks:

LOT A

RECORD

Cased _____ in., _____ ft.

Sand 1640-73

Gas _____

Oil _____

Total Depth 1676

PRODUCTION

1st 24 hrs. Nat. _____

1st 24 hrs. after shot _____

Gas _____ Cu. Ft.

Dry Hole _____

Abandoned _____

Date

5-16-34 19

ORVAL MANNSCHRECK

Scout