


Map No. Kansas Sec. 19 Twp. 25 R. 11
Well No. 1 Brookover Farm
Fisher-Lancke Company

NORTH

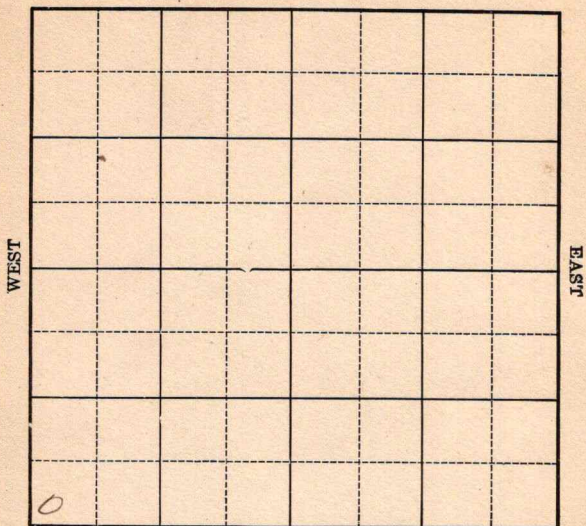

SOUTH

Location _____
Drilling Remarks _____

Rig Up _____
Drilling Remarks _____

RECORD

Cased _____ in. _____ ft.
Sand _____
Gas _____
Oil _____
Total Depth _____

PRODUCTION

1st 24 hrs. Nat. _____
1st 24 hrs. after shot _____
Gas _____ cu. ft.
Dry Hole _____
Abandoned _____

K16 KANSAS

Map No. _____ Sec. 19 Twp. 25 R. 11

Well No. 1. BROOKOVER
Fisher & Hancock Company

Contractor

FIRST REPORTS

SECTION PLAT

o			

Ft. from N. Line

330

Ft. from S. Line

Ft. from E. Line

330

Ft. from W. Line

Location ✓

Rig up

Drilling and Remarks:

RECORD

Cased _____ in., _____ ft.

Sand _____

Gas _____

Oil _____

Total Depth _____

PRODUCTION

1st 24 hrs. Nat. _____

1st 24 hrs. after shot _____

Gas _____ Cu. Ft.

Dry Hole _____

Abandoned _____

Date

MAY 19 1926

192 CHAS. L. SHERWOOD Scout

K16 KANSAS
 Map No. *19* Sec. *25* Twp. *11*

Well No. *1*
Fisher & Luccio Company

Contractor

COMPLETED

SECTION PLAT

Ft. from N. Line

330

Ft. from S. Line

Ft. from E. Line

330

Ft. from W. Line

ABANDONED

o			

Location

Rig up

Drilling and Remarks:

sand 1802-17'
sdg shab 1850-60

th 1997'

DDG 2045 ft

RECORD

Cased _____ in., _____ ft.

Sand _____

Gas _____

Oil _____

Total Depth *2045'*

PRODUCTION

1st 24 hrs. Nat. _____

1st 24 hrs. after shot _____

Gas _____ Cu. Ft.

Dry Hole ☒

Abandoned ☒

Date

JUL 21 1926

192

CHAS. L. SHERWOOD

Scout