
FORM 51 25M 3-49 PETROL KANSAS Greenwood

Section 16 Township 25 Range 11-E

Well No. #1 Scott

Company S. Winters

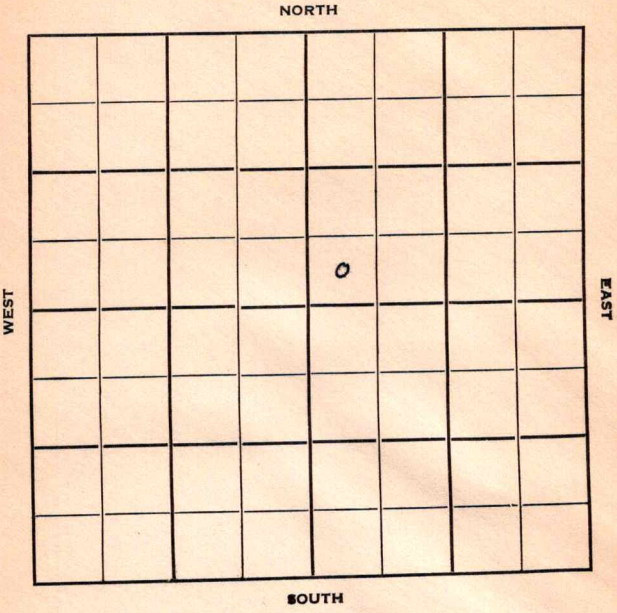

FORM 252-B
10M 9-49 PETROL

KANSAS

Greenwood

Sec. 16 Twp. 25 R. 11-E

Well No. #1 Scott Farm

S. Winters Company

Berentz Contractor


____ Ft. from N. Line

330 Ft. from S. Line

____ Ft. from E. Line

330 Ft. from W. Line

SW SW NE

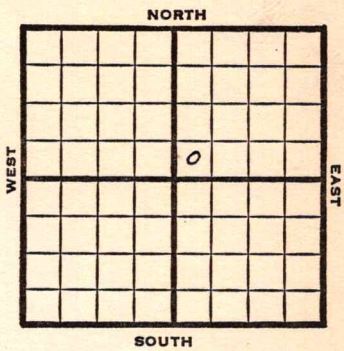

1950	? REPORT
10/18	RUR
12/6	Spud 10-20-50 12" @ 175 8" @ 975 Bart 1650-56 TD 1710 D&A ABANDONED

FORM 275 FOR SALE BY KANSAS BLUE PRINT CO.


County Greenwood State Kansas

Sec. 16 (Blk. Twp.) 25 (Sur. Rge.) 11E Map No.

Operator S. Winters

Well No. 1 Farm Scott

Elev. Location SW SW NE

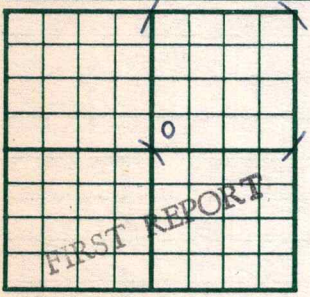

330 Ft. From S Line NE

330 Ft. From W Line Quarter

1st. Report OCT 18 1950

Completion

Remarks Berentz - Contr.

Spudding Date

Drlg. Data

R U R

J. E. TYRA

FORM 275 FOR SALE BY KANSAS BLUE PRINT CO.


County Greenwood State Kansas

Sec. 16 (Blk. Twp.) 25 (Sur. Rge.) 11E Map No.

Operator S. Winters

Well No. 1 Farm Scott

Elev. Location SW SW NE

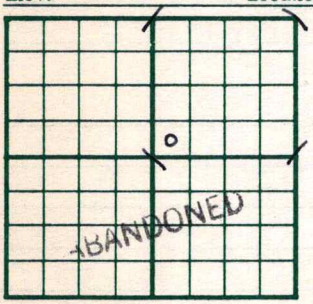

330 Ft. From S Line NE

330 Ft. From W Line Quarter

1st. Report

Completion DEC 6 1950

Remarks

Berentz - Contr.

Spudding Date 10-20-50

Drlg. Data D & A TD 1710

12" @ 175 8" @ 975 Bart. 1650-56

TD 1710 D & A

J. E. TYRA