

Map No. _____ Sec. 2 Twp. 27 R. 5Well No. #3 Wright Farm _____Derby et al. Company _____

NORTH

WEST

EAST

SOUTH

Location _____

Rig Up _____

Drilling Remarks:

Drilling Remarks:

RECORD

Cased _____ in. _____ ft.

Sand _____

Gas _____

Oil _____

Total Depth _____

PRODUCTION

1st 24 hrs. Nat. _____

1st 24 hrs. after shot _____

Gas _____ cu. ft

Dry Hole _____


Abandoned _____

Map No. K-11 Sec. 2 Twp. 27 R. 5
 Well No. 3 Wright Farm
Derby, Ohio Company

NORTH

WEST

EAST

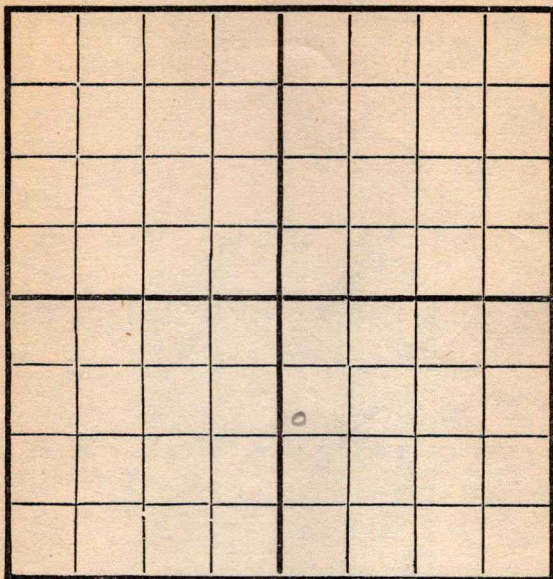

SOUTH

Location -----

Rig Up ☒ -----

Drilling and remarks -----

RECORD

Cased ----- in. ----- Ft.

Sand -----

Gas -----

Oil -----

Total Depth -----

PRODUCTION

1st 24 hrs. Nat. -----

1st 24 hrs. after shot -----

Gas ----- Cu. Ft.

Dry Hole -----

Abandoned -----

First Report

Date

6/12, 1917, Carroll Scout

Map No. _____ Sec. 2 Twp. 27 R. 5Well No. 3 Wright Farm _____

_____ Company _____

NORTH

WEST

EAST

SOUTH

Location _____

Rig Up ☒ _____

Drilling and remarks _____

RECORD

Cased _____ in. _____ Ft.

Sand _____

Gas _____

Oil _____

Total Depth _____

PRODUCTION

1st 24 hrs. Nat. _____

1st 24 hrs. after shot _____

Gas _____ Cu. Ft.

Dry Hole _____

Abandoned _____

Date

6/14, 1917, Condit Scout


FIRST REPORT

FIRST REPORT

FIRST REPORT

Map No. _____ Sec. 2 Twp. 27 R. 5
Well No. 3 20 rights Farm _____
Denby Detap Company _____

NORTH

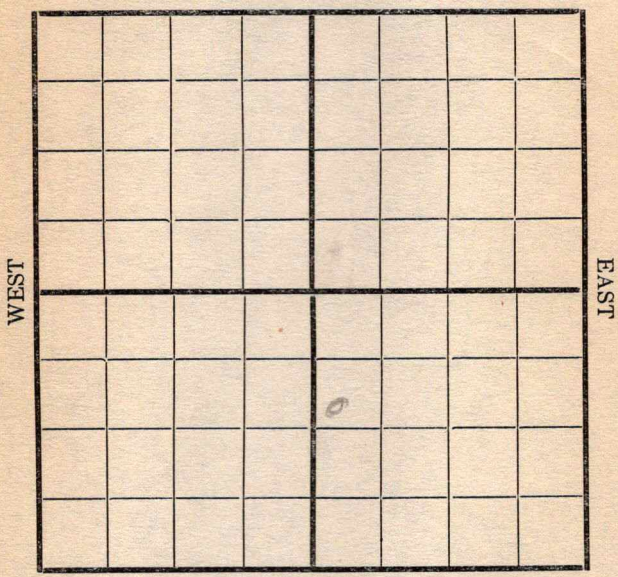

SOUTH

Location _____
Rig Up _____
Drilling and remarks _____

RECORD

Cased _____ in. _____ Ft.
Sand _____
Gas _____
Oil _____
Total Depth _____


PRODUCTION

1st 24 hrs. Nat. _____
1st 24 hrs. after shot _____
Gas _____ Cu. Ft.
Dry Hole _____
Abandoned _____

Date 6/20, 1917 Carly Scout _____

Map No. _____ Sec. 2 Twp. 27 R. 5
 Well No. 3 Wright Farm _____
Denby et al Company _____

NORTH

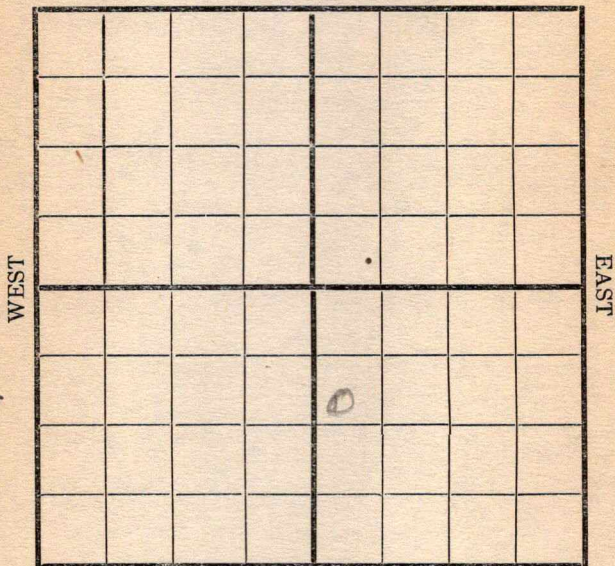

SOUTH

Location _____

Rig Up _____

Drilling and remarks

*Rigging
up*

RECORD

Cased _____ in. _____ Ft.

Sand _____

Gas _____

Oil _____

Total Depth _____

PRODUCTION

1st 24 hrs. Nat. _____

1st 24 hrs. after shot _____

Gas _____ Cu. Ft.

Dry Hole _____


Abandoned _____

Date

6/27, 1917 Conley Scout

Map No. _____ Sec. 2 Twp. 27 R. 5Well No. 3 Wright Farm _____Deery, et al Company _____

NORTH

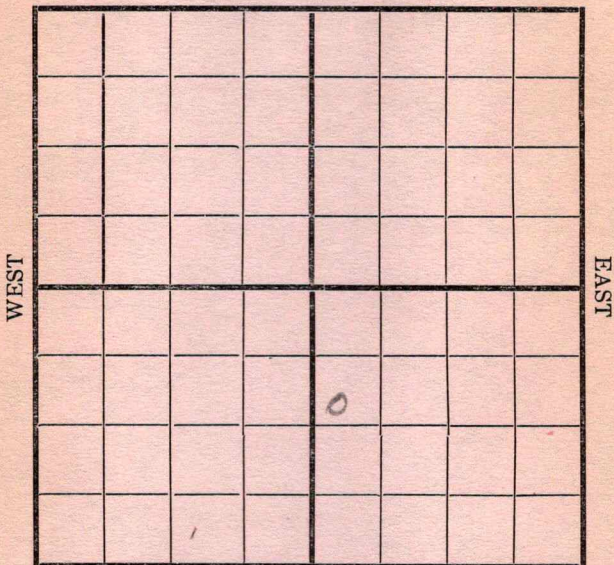

SOUTH

Location _____

Rig Up _____

Drilling and remarks

Sand

RECORD

Cased _____ in. _____ Ft.

Sand _____

Gas _____

Oil _____

Total Depth _____

PRODUCTION

1st 24 hrs. Nat. _____

1st 24 hrs. after shot _____

Gas _____ Cu. Ft.

Dry Hole _____

Abandoned _____

Date


7/6, 191 2Carly Scout

Map No. _____ Sec. 2 Twp. 27 R. 5Well No. 3 Wright Farm _____

Company _____

NORTH

WEST

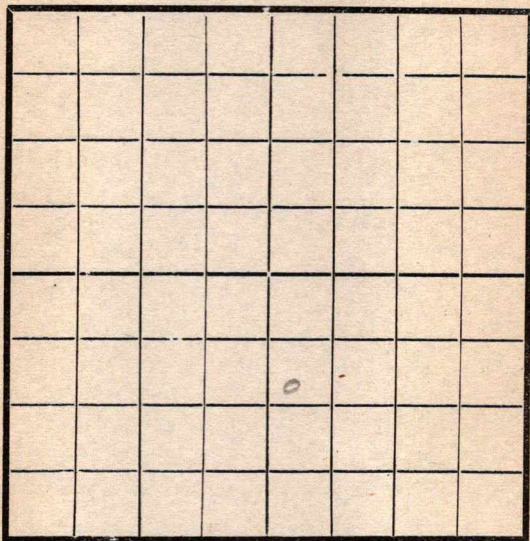

EAST

SOUTH

Location _____

Rig Up _____

Drilling and remarks

Shut Down
500

RECORD

Cased _____ in _____ Ft.

Sand _____

Gas _____

Oil _____

Total Depth _____

PRODUCTION

1st 24 hrs. Nat. _____

1st 24 hrs. after shot _____

Gas _____ Cu. Ft.

Dry Hole _____

Abandoned _____


Date

7/12, 1912 C. Condy Scout

Map No. _____ Sec. 2 Twp. 27 R. 5Well No. 3 Wright Farm _____Seelye & Co. Company _____

NORTH

WEST

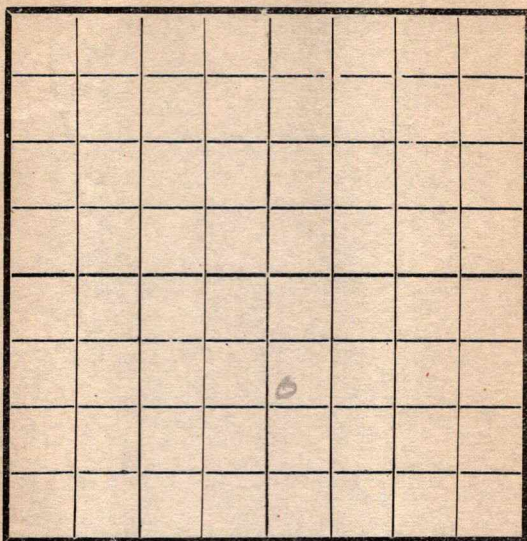

EAST

SOUTH

Location _____

Rig Up _____

Drilling and remarks

460

RECORD

Cased _____ in. _____ Ft.

Sand _____

Gas _____

Oil _____

Total Depth _____

PRODUCTION

1st 24 hrs. Nat. _____

1st 24 hrs. after shot _____


Gas _____ Cu. Ft.

Dry Hole _____

Abandoned _____

Date

7/17, 1917 Condy Scout

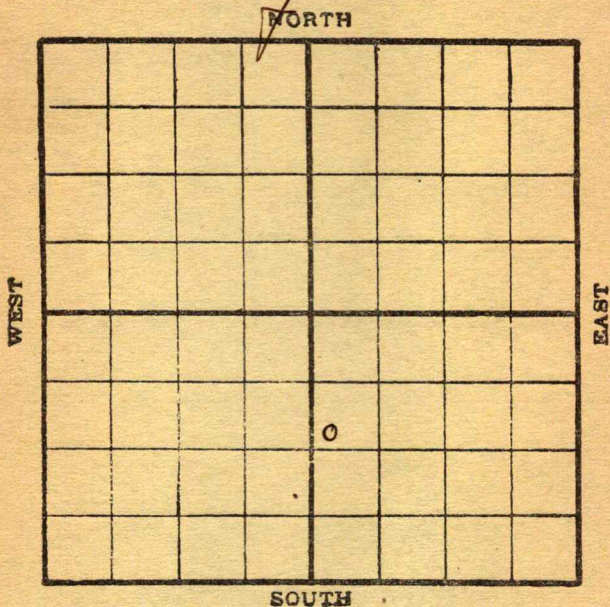Map No. _____ Sec. 2 Twp. 27 R. 5Well No. 3 Wright Farm _____Derby et al Company _____

Location _____

Rig up _____

Drilling and remarks:

720

RECORD

Cased _____ in. _____ Ft.

Sand _____

Gas _____

Oil _____

Total Depth _____

PRODUCTION

1st. 24 hrs. Nat. _____

1st. 24 hrs. after shot _____

Gas _____ Cu. Ft.

Dry Hole _____

Abandoned _____

Date


7/27 1917, Condy Scout

Map No. _____ Sec. 7 Twp. 27 R. 5

Well No. 3 Wright Farm _____

Dubby et al Company _____

NORTH

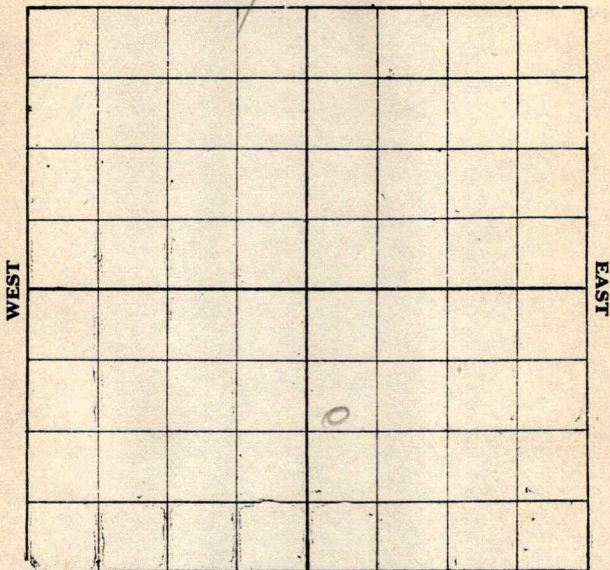

SOUTH

RECORD

Location _____

Cased _____ in. _____ Ft.

Rig up _____

Sand _____

Drilling and Remarks:

Gas _____

1180

Oil _____

Total Depth _____

PRODUCTION

1st 24 hrs. Nat. _____

1st 24 hrs. after shot _____

Gas _____ Cu. Ft.

Dry Hole _____

Abandoned _____

Date

8/1, 1917, Carney Scout

Map No. _____ Sec. 2 Twp. 27 R. 5Well No. 3 Wright Farm _____

Company _____

NORTH

WEST

EAST

SOUTH

Location _____

Rig Up _____

Drilling and remarks

2125

RECORD

Cased _____ in. _____ Ft.

Sand _____

Gas _____

Oil _____

Total Depth _____

PRODUCTION

1st 24 hrs. Nat. _____

1st 24 hrs. after shot _____

Gas _____ Cu. Ft.

Dry Hole _____

Abandoned _____

Date


8/17, 1917 Conley Scout

Map No. _____ Sec. 3, Twp. 27 R. 5
Well No. 3. Wright Farm _____
Derby et al Company _____

NORTH

WEST

EAST

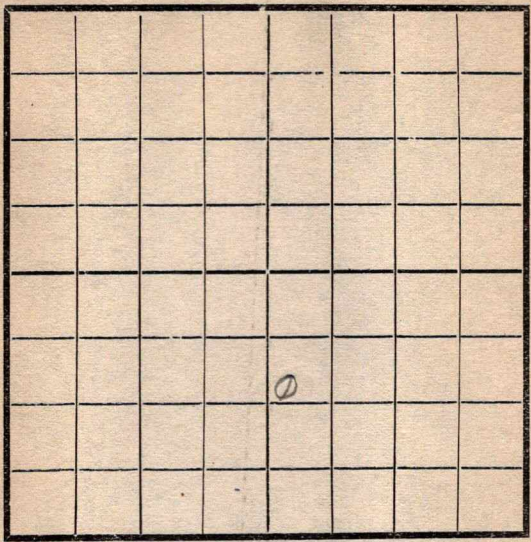

SOUTH

	RECORD
Location _____	Cased _____ in. _____ Ft.
Rig Up _____	Sand _____
Drilling and remarks	Gas _____
<u>Settling 6" at</u> <u>2660.</u>	Oil _____
	Total Depth _____
	PRODUCTION
	1st 24 hrs. Nat. _____
	1st 24 hrs. after shot _____
	Gas _____ Cu. Ft.
	Dry Hole _____
	Abandoned _____


Date 8-21, 1917 Lantz Scout

Map No. _____ Sec. 2 Twp. 27 R. 5Well No. 3. Wright Farm _____Derby Company _____

NORTH

WEST

EAST

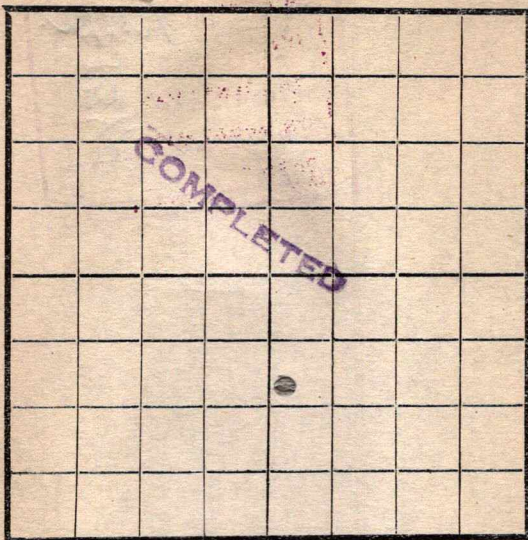

SOUTH

Location _____

Rig Up _____

Drilling and remarks _____

RECORD

Cased _____ in _____ Ft.

Sand 2696-2717

Gas _____

Oil ☒ _____Total Depth 2717

PRODUCTION

1st 24 hrs. Nat. 50 Bbls

1st 24 hrs. after shot _____

Gas _____ Cu. Ft.

Dry Hole _____

Abandoned _____

Date

9-1-17, 1917Lantz Scout