


Map No. _____ Sec. 2 Twp. 27 R. 5Well No. 3 Smock Farm _____Haverhill Pet Company _____

NORTH

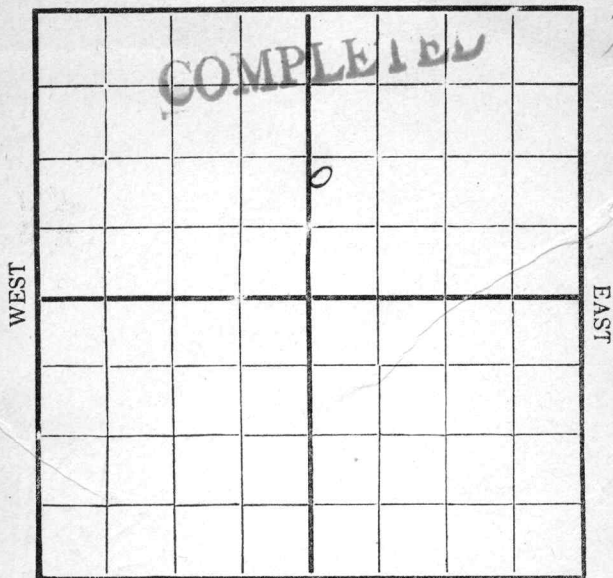

SOUTH

Location _____

Rig Up _____

Drilling Remarks:

Drilling Remarks:

RECORD

PRODUCTION

Cased _____ in _____ Ft.

1st 24 hrs. Nat. _____

Sand _____

1st 24 hrs. after shot _____

Gas _____

Gas _____ Cu. Ft.

Oil _____


Dry Hole _____

Total Depth _____

Abandoned _____

Map No. _____ Sec. 2 Twp. 27 R. 5
 Well No. 3 Smock Farm
Haverhill Pet. Co. Company

NORTH

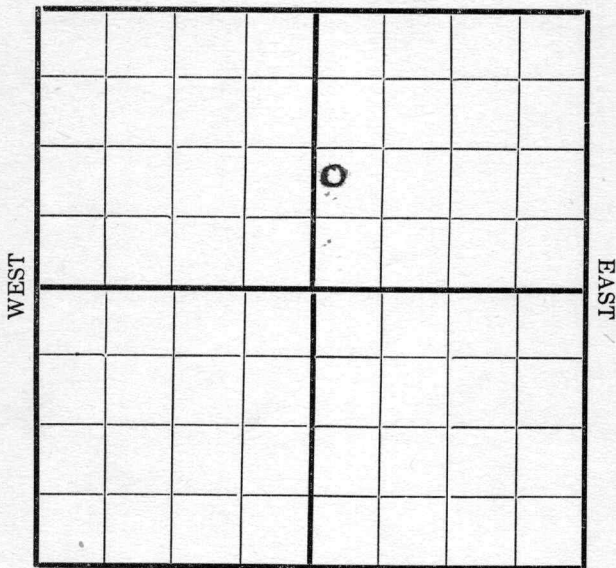

SOUTH

Location _____
 Rig Up _____
 Drilling and remarks _____

*1100' from south
 line 300' from
 West line.
 Loc.
 JHP*

RECORD

Cased _____ in. _____ Ft.
 Sand _____
 Gas _____
 Oil _____
 Total Depth _____

PRODUCTION


1st 24 hrs. Nat. _____
 1st 24 hrs. after shot _____
 Gas _____ Cu. Ft.
 Dry Hole _____
 Abandoned _____

Date

3/21, 1917 E. J. Crocker Scout

Map No. _____ Sec. 2 Twp. 27 R. 5
 Well No. 3 Smock Farm _____
Haverhill Pk. Company

NORTH

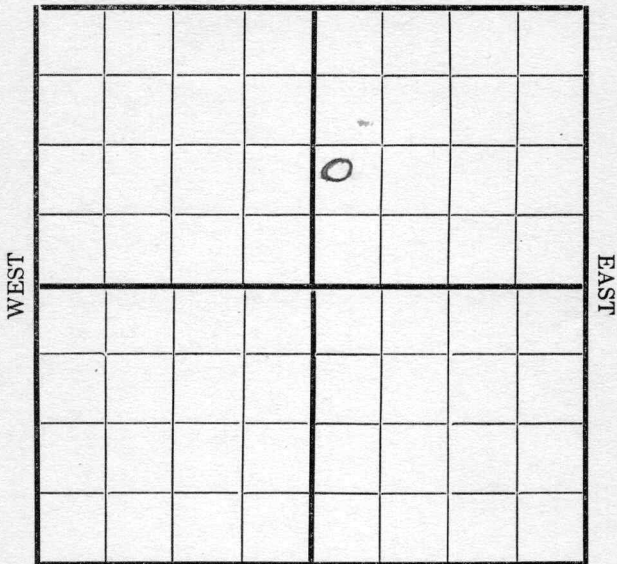

SOUTH

Location _____

Rig Up _____

Drilling and remarks

Rig up

RECORD

Cased _____ in. _____ Ft.

Sand _____

Gas _____

Oil _____

Total Depth _____

PRODUCTION

1st 24 hrs. Nat. _____

1st 24 hrs. after shot _____

Gas _____ Cu. Ft.

Dry Hole _____

Abandoned _____


Date

MAR 3 1 1917

G. J. Crocker Scout

Map No. _____ Sec. 2 Twp. 27 R. 5
 Well No. 3 Smock Farm _____
Haverhill Pet. Company

NORTH

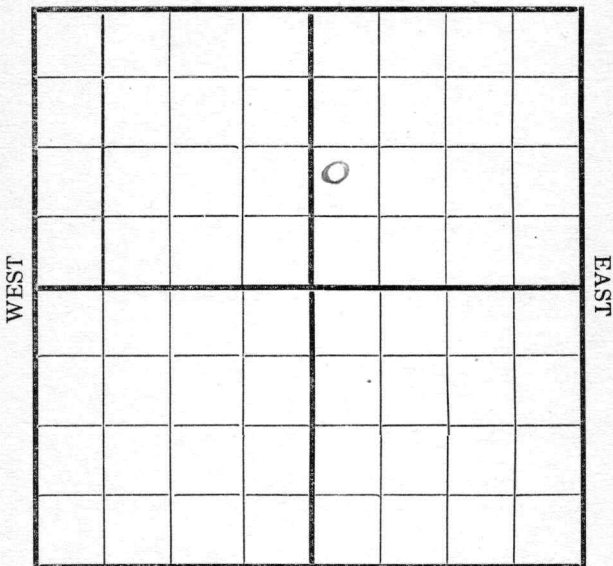

SOUTH

Location _____
 Rig Up _____
 Drilling and remarks

*Rigging
up*

RECORD

Cased _____ in. _____ Ft.
 Sand _____
 Gas _____
 Oil _____
 Total Depth _____

PRODUCTION

1st 24 hrs. Nat. _____
 1st 24 hrs. after shot _____
 Gas _____ Cu. Ft.
 Dry Hole _____
 Abandoned _____


Date

APR 7, 1917

C. J. Crocker
 Scout

Map No. _____ Sec. 2 Twp. 27 R. 5Well No. 3 Smock Farm _____Haverhill Pit Company _____

NORTH

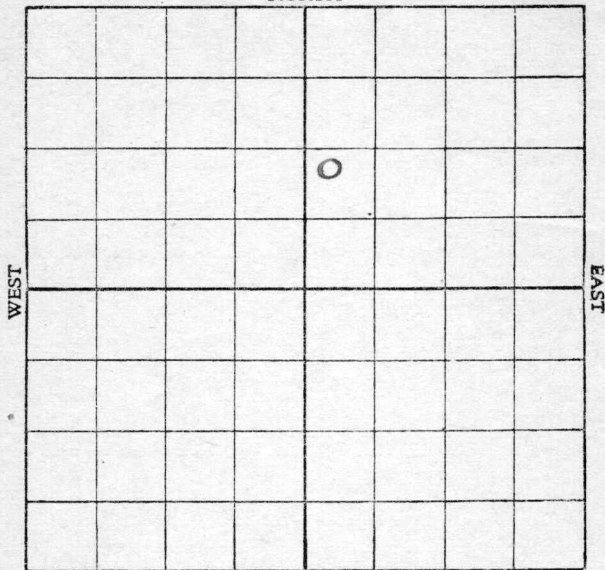

SOUTH

Location _____

Rig up _____

Drilling and remarks:

RECORD

Cased _____ in. _____ Ft.

Sand _____

Gas _____

Oil _____

Total Depth _____

PRODUCTION

1st 24 hrs. Nat. _____

1st 24 hrs. after shot _____

Gas _____ Cu. Ft.

Dry Hole _____

Abandoned _____

Date

APR 14 1911

191

C. T. Crocker Scout


Butler

Map No. _____ Sec. *2* Twp. *27* R. *5*
 Well No. *3 Amock* Farm _____
Haverhill Pet. Company _____

NORTH

WEST

EAST

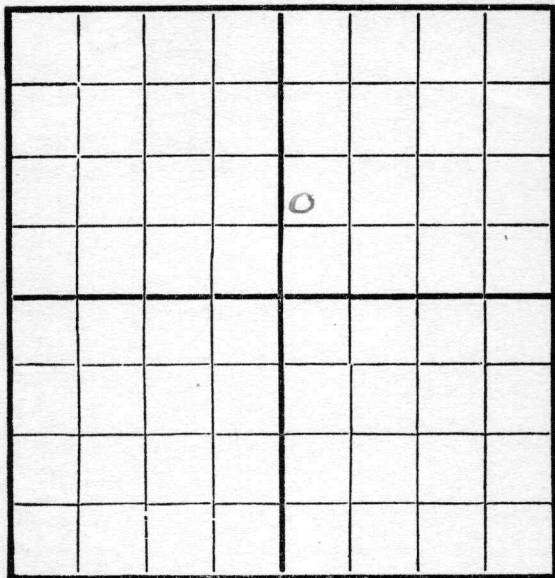

SOUTH

Location _____

Rig Up _____

Drilling and remarks

D. - 660'

RECORD

Cased _____ in. _____ Ft.

Sand _____

Gas _____

Oil _____

Total Depth _____

PRODUCTION

1st 24 hrs. Nat. _____

First 24 hrs. after shot _____

Gas _____ Cu. Ft.

Dry Hole _____

Abandoned _____

Date

*APR 21, 1917**G. J. Crocker*

Scout


Butler

Map No. _____ Sec. *2* Twp. *27* R. *5*

Well No. *3 Smock* Farm _____

Haverhill Pet. Company _____

NORTH

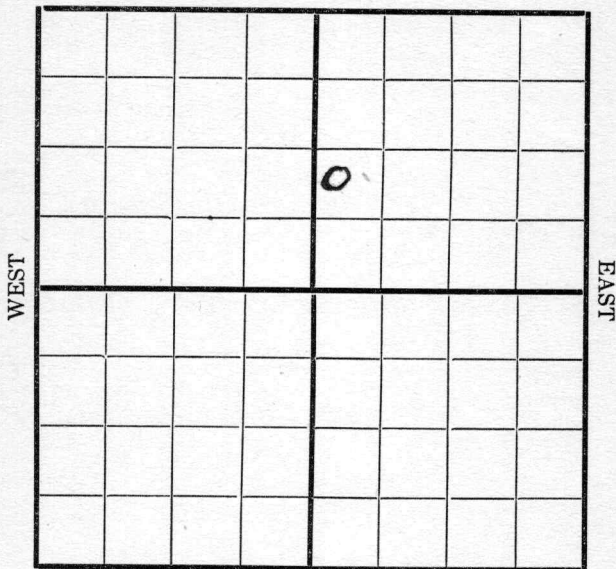

SOUTH

Location _____

Rig Up _____

Drilling and remarks _____

Fishing
700'

RECORD

Cased _____ in. _____ Ft.

Sand _____

Gas _____

Oil _____

Total Depth _____

PRODUCTION

1st 24 hrs. Nat. _____

1st 24 hrs. after shot _____

Gas _____ Cu. Ft.

Dry Hole _____


Abandoned _____

Date

4/28, 19*17* *Dwicker* Scout

Map No. _____ Sec. 2 Twp. 27 R. 5
 Well No. 3 _____ Farm _____

NORTH

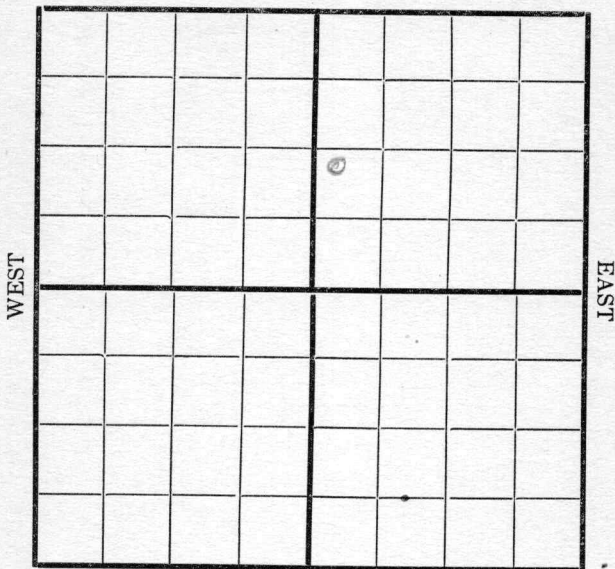

SOUTH

Location _____
 Rig Up _____
 Drilling and remarks _____

Fishing
700'

RECORD

Cased _____ in. _____ Ft.
 Sand _____
 Gas _____
 Oil _____
 Total Depth _____

PRODUCTION

1st 24 hrs. Nat. _____
 1st 24 hrs. after shot _____
 Gas _____ Cu. Ft.
 Dry Hole _____
 Abandoned _____


Date 5/2, 1917 Candy Scout

Map No. _____ Sec. 2 Twp. 27 R. 5



NORTH

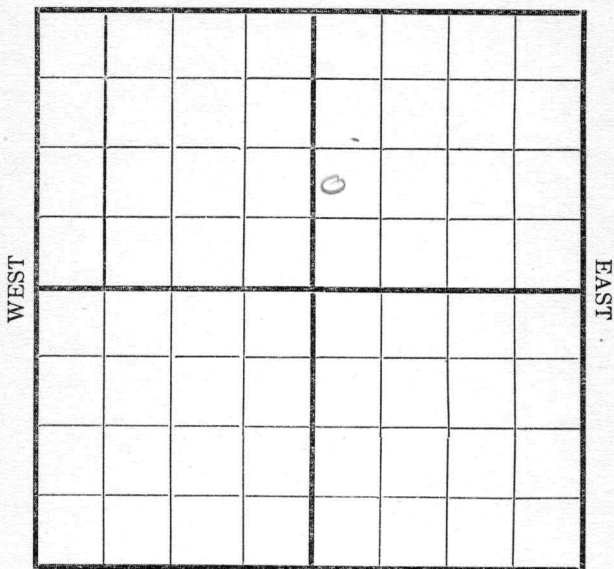

SOUTH

Location _____

Rig Up _____

Drilling and remarks

1120

RECORD

Cased _____ in. _____ Ft.

Sand _____

Gas _____

Oil _____

Total Depth _____

PRODUCTION

1st 24 hrs. Nat. _____

1st 24 hrs. after shot _____

Gas _____ Cu. Ft.

Dry Hole _____


Abandoned _____

Date

5/11, 1917 Carling Scout

Map No. _____ Sec. 2 Twp. 27 R. 5
 Well No. 3 Snook Farm _____
Horseshill Petro Company

NORTH

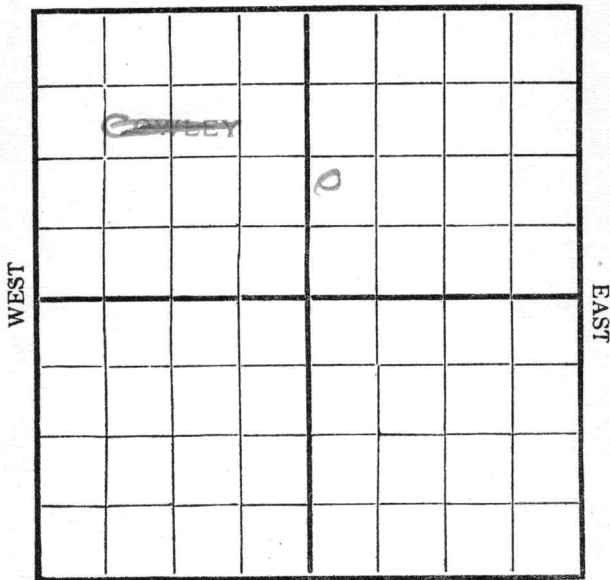

SOUTH

Location _____
 Rig Up _____
 Drilling and remarks

2100'

RECORD

Cased _____ in. _____ Ft.
 Sand _____
 Gas _____
 Oil _____
 Total Depth _____

PRODUCTION


1st 24 hrs. Nat. _____
 1st 24 hrs. after shot _____
 Gas _____ Cu. Ft.
 Dry Hole _____
 Abandoned _____

Date

5/25 191 7 Cardiff Scout

Map No. _____ Sec. 2 Twp. 27 R. 5Well No. 3 Sumner Farm
Harcill Petroleum Company

NORTH

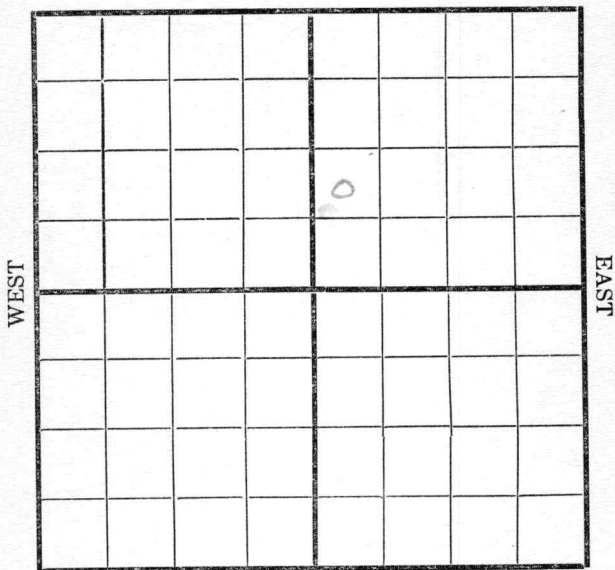

SOUTH

Location _____

Rig Up _____

Drilling and remarks

2100

RECORD

Cased _____ in. _____ Ft.

Sand _____

Gas _____

Oil _____

Total Depth _____

PRODUCTION

1st 24 hrs. Nat. _____

1st 24 hrs. after shot _____

Gas _____ Cu. Ft.

Dry Hole _____

Abandoned _____

Date


5/28 191 7 Candys Scout

Map No. _____ Sec. 2 Twp. 27 R. 5
 Well No. 3 Swick Farm
Harcill Peter Company

NORTH

WEST

EAST

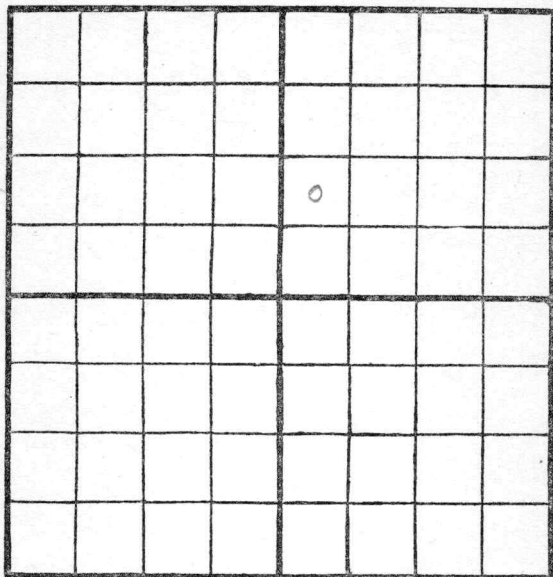

SOUTH

Location _____

Rig Up _____

Drilling and remarks

2615

RECORD

Cased _____ in. _____ Ft.

Sand _____

Gas _____

Oil _____

Total Depth _____

PRODUCTION

1st 24 hrs. Nat. _____

1st 24 hrs. after shot _____

Gas _____ Cu. Ft.

Dry Hole _____

Abandoned _____


Date

6/8, 1917, Carly Scout

Map No. _____ Sec. 2 Twp. 27 R. 5
 Well No. 3 Snook Farm
Donnell Petroleum Company

NORTH

WEST

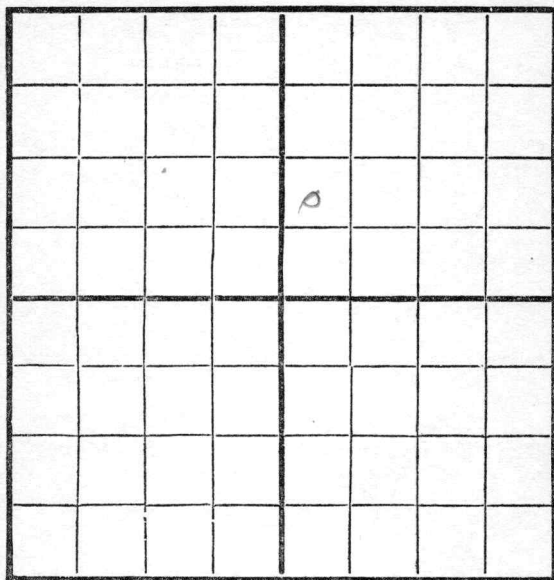

EAST

SOUTH

Location _____

Rig Up _____

Drilling and remarks

Top sand
2662'

Pulling big
pipe

RECORD

Cased _____ in. _____ Ft.

Sand _____

Gas _____

Oil _____

Total Depth _____

PRODUCTION

1st 24 hrs. Nat. _____

1st 24 hrs. after shot _____

Gas _____ Cu. Ft.

Dry Hole _____


Abandoned _____

Date

6/15, 1917, 7 Carroll Scout

Map No. K-11 Sec. 2 Twp. 27 R. 5
 Well No. 3 Smack Farm
Harrell Petroleum Company

NORTH

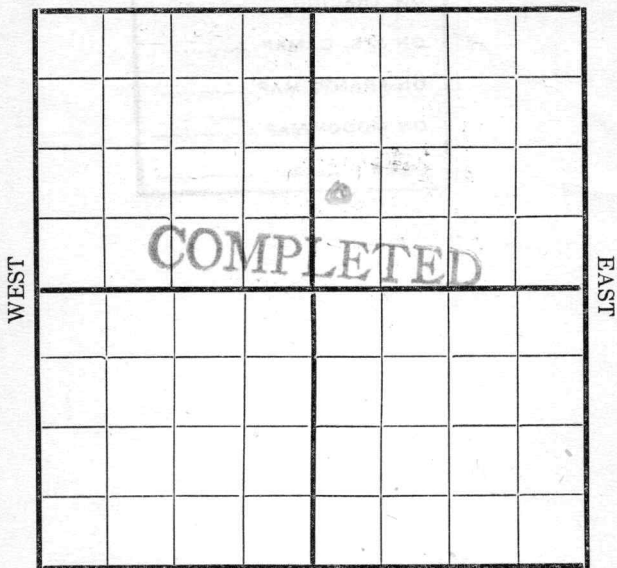

SOUTH

Location _____
 Rig Up _____
 Drilling and remarks

• *swabbing*
Estimated
good for
250 Bbls

RECORD

Cased _____ in. _____ Ft.
 Sand 2662 - 2684
 Gas _____
 Oil _____
 Total Depth _____

PRODUCTION

1st 24 hrs. Nat. _____
 1st 24 hrs. after shot _____
 Gas _____ Cu. Ft.
 Dry Hole _____
 Abandoned _____

Date

6/21, 1917 *Cordiff* Scout