

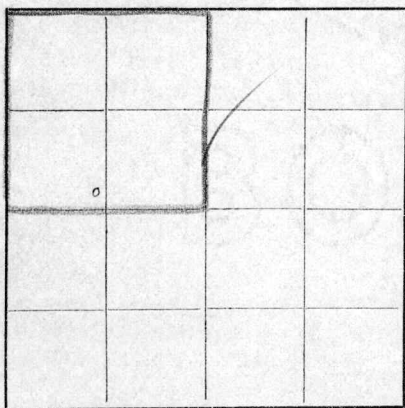
2-27-5E

## LOCATION NOTICE

Tulsa, Okla., Dec. 18, 1917. 1917 No. 155To LEONARD LOOP,Address AUGUSTA, KANS.

J. S. COSDEN will drill a well  
as described below, and this notice will be your authority for commencement of work.

The location will be on J. B. SMOCK Farm  
in W/2 of the NW/4 of Section 2 Township 27-S Range 5-E  
BUTLER County, State of KANSAS

Well No. 4

\_\_\_\_\_ feet from North line

50 feet from East line290 feet from South line

\_\_\_\_\_ feet from West line

Remarks: \_\_\_\_\_

Copies to

Accounting Dept.  
Engineering Dept.  
Legal Dept.  
Rental Dept.  
Scouting Dept.

(Signed) Tom Moody