


Map No. _____ Sec. 2 Twp. 27 R. 5
 Well No. 6. C.A. Smock Farm _____
Producers Oil Company

NORTH

WEST

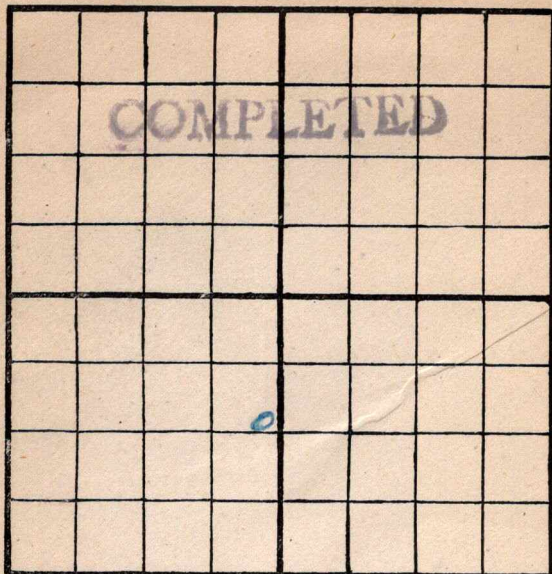

EAST

SOUTH

Location _____

Rig Up _____

Drilling Remarks:

Drilling Remarks:

RECORD

Cased _____ in. _____ ft.

Sand _____

Gas _____

Oil _____

Total Depth _____

PRODUCTION

1st 24 hrs. Nat. _____

1st 24 hrs. after shot _____

Gas _____ cu. ft

Dry Hole _____


Abandoned _____

Map No. 15-11 Sec. 2 Twp. 27 R. 5
 Well No. C. C. A. Dmoch Farm
Producers Oil Company

NORTH

WEST

EAST

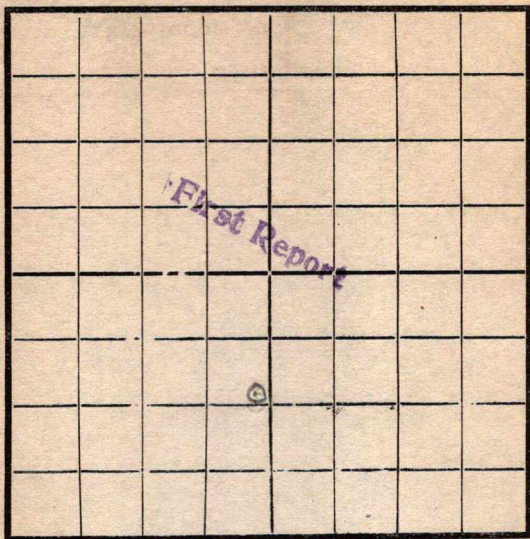

SOUTH

RECORD

Location -----

Cased ----- in. ----- Ft.

Rig Up -----

Sand -----

Drilling and remarks

Gas -----

Oil -----

Total Depth -----

PRODUCTION

1st 24 hrs. Nat. -----

1st 24 hrs. after shot -----

Gas ----- Cu. Ft.

Dry Hole -----

Abandoned -----

Date

8-21, 1917 Lantz Scout

Map No. _____ Sec. 2 Twp. 27 R. 5Well No. 6 _____ Farm __________
Company _____

NORTH

WEST

EAST

SOUTH

Location _____

Rig Up _____

Drilling and remarks

400'

RECORD

Cased _____ in. _____ Ft.

Sand _____

Gas _____

Oil _____

Total Depth _____

PRODUCTION

1st 24 hrs. Nat. _____

1st 24 hrs. after shot _____

Gas _____ Cu. Ft.

Dry Hole _____

Abandoned _____

Date


9/19, 1917Cordell

Scout

Map No. _____ Sec. 2 Twp. 27 R. 5Well No. 6500000 Farm _____Company Producers

NORTH

WEST

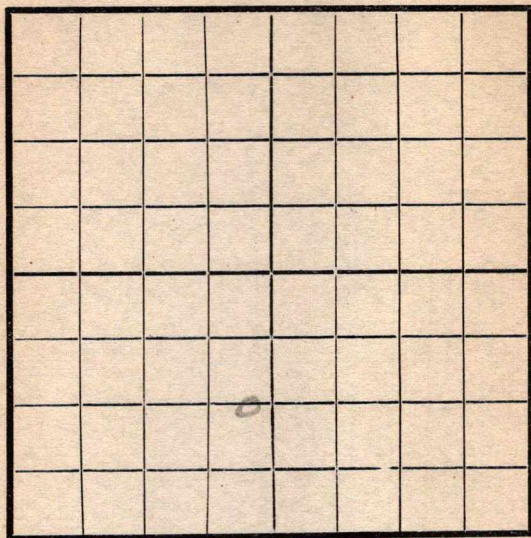

EAST

SOUTH

Location _____

Rig Up _____

Drilling and remarks

970

RECORD

Cased _____ in. _____ Ft.

Sand _____

Gas _____

Oil _____

Total Depth _____

PRODUCTION

1st 24 hrs. Nat. _____

1st 24 hrs. after shot _____

Gas _____ Cu. Ft.

Dry Hole _____

Abandoned _____


Date

9/7, 1917 C. J. Jeff

Scout

Map No. _____ Sec. 2 Twp. 27 R. 5
 Well No. 6 Swack Farm _____
Producers Company _____

NORTH

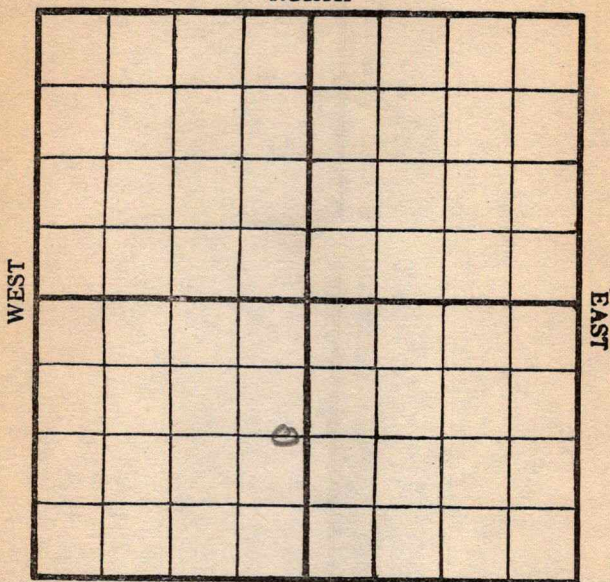

SOUTH

Location _____

Rig Up _____

Drilling and remarks

1420

RECORD

Cased _____ in. _____ Ft.

Sand _____

Gas _____

Oil _____

Total Depth _____

PRODUCTION

1st 24 hrs. Nat. _____

1st 24 hrs. after shot _____

Gas _____ Cu. Ft.

Dry Hole _____

Abandoned _____


Date

10/2, 1912 Candiff Scout _____

Map No. _____ Sec. 2 Twp. 27 R. 5Well No. 6 Smuck Farm _____
Producers Company

NORTH

WEST

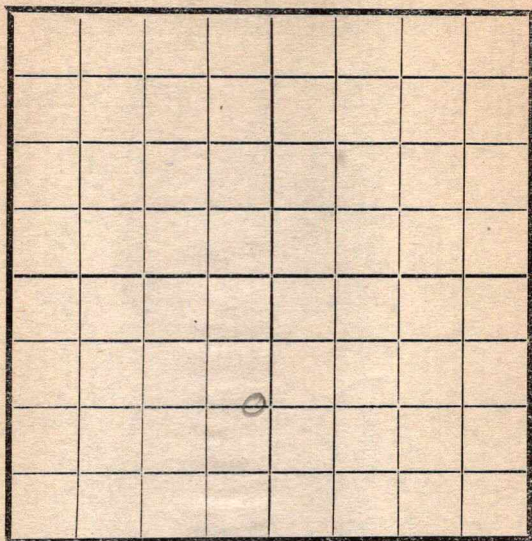

EAST

SOUTH

Location _____

Rig Up _____

Drilling and remarks

1620

RECORD

Cased _____ in _____ Ft.

Sand _____

Gas _____

Oil _____

Total Depth _____

PRODUCTION

1st 24 hrs. Nat. _____

1st 24 hrs. after shot _____

Gas _____ Cu. Ft.

Dry Hole _____

Abandoned _____

Date


10/9, 1912 Carney Scout

Map No. _____ Sec. 2 Twp. 27 R. 5Well No. 6 smooth Farm _____
Producers Company

NORTH

WEST

EAST

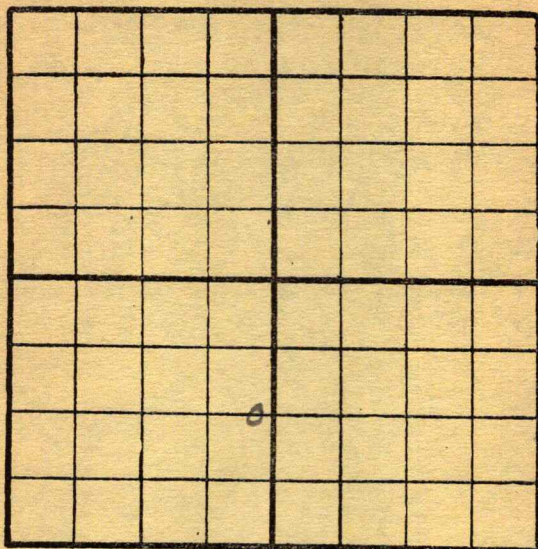

SOUTH

Location _____

Rig up _____

Drilling and remarks:

2310

RECORD

Cased _____ in. _____ Ft.

Sand _____

Gas _____

Oil _____

Total Depth _____

PRODUCTION

1st. 24 hrs. Nat. _____

1st. 24 hrs. after shot _____

Gas _____ Cu. Ft.

Dry Hole _____

Abandoned _____


Date

10/17, 1917, Cordy, Scout

Map No. _____ Sec. 2 Twp. 27 R. 5
Well No. 6 Quinn Farm
Producers Company

NORTH

WEST

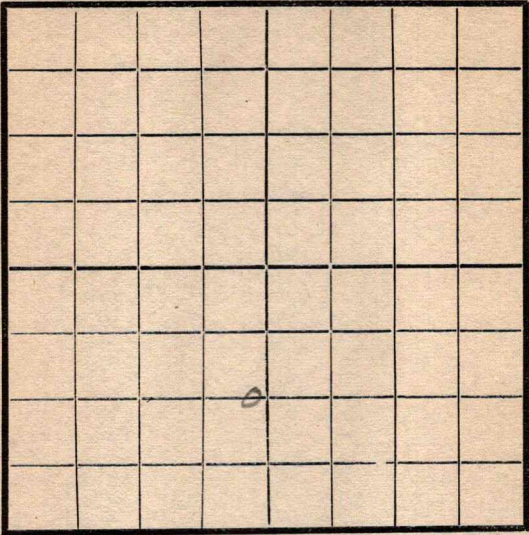

EAST

SOUTH

Location _____
Rig Up _____
Drilling and remarks

Tap sand
2665

RECORD

Cased _____ in. _____ Ft.
Sand _____
Gas _____
Oil _____
Total Depth _____

PRODUCTION


1st 24 hrs. Nat. _____
1st 24 hrs. after shot _____
Gas _____ Cu. Ft.
Dry Hole _____
Abandoned _____

Date
10/24, 1917 Carroll Scout

Map No. _____ Sec. 2 Twp. 27 R. 5Well No. 6 Smoak Farm _____Producers Oil Company _____

NORTH

WEST

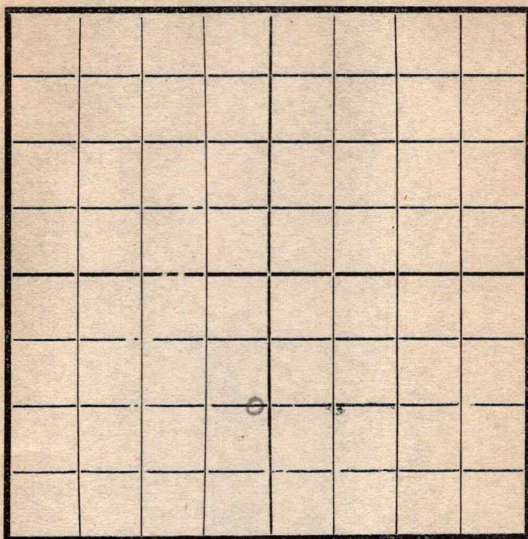

EAST

SOUTH

RECORD

Location _____

Cased _____ in. _____ Ft.

Rig Up _____

Sand _____

Drilling and remarks

Gas _____

Oil _____

Total Depth _____

PRODUCTION

1st 24 hrs. Nat. _____

1st 24 hrs. after shot _____

Gas _____ Cu. Ft.

Dry Hole _____

Abandoned _____

Date.


10/31, 1917 C. O. S. Scout

Map No. K11 Sec. 2 Twp. 27 R. 5

Well No. 6 Smoot Farm Producers Company

NORTH

WEST

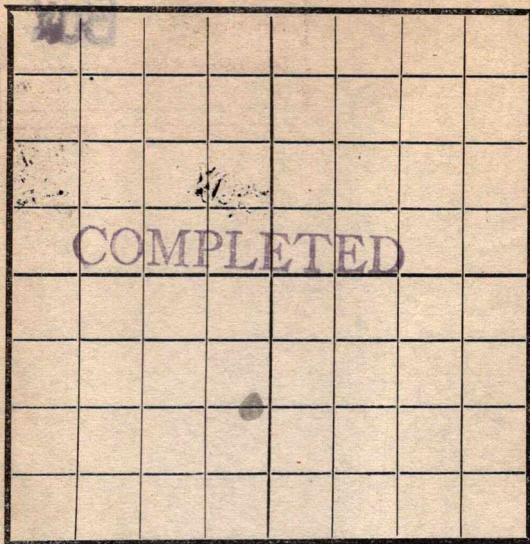

EAST

SOUTH

Location -----

Rig Up -----

Drilling and remarks

Exat
90
Barrels

RECORD

Cased ----- in ----- Ft.

Sand 2665-2205

Gas -----

Oil -----

Total Depth -----

PRODUCTION

1st 24 hrs. Nat. -----

1st 24 hrs. after shot -----

Gas ----- Cu. Ft.

Dry Hole -----

Abandoned -----

Date


11-7, 1917 Cord Scout

Map No. _____ Sec. 8 Twp. 27 R. 5

Well No. _____ Farm _____

_____ Company _____

NORTH

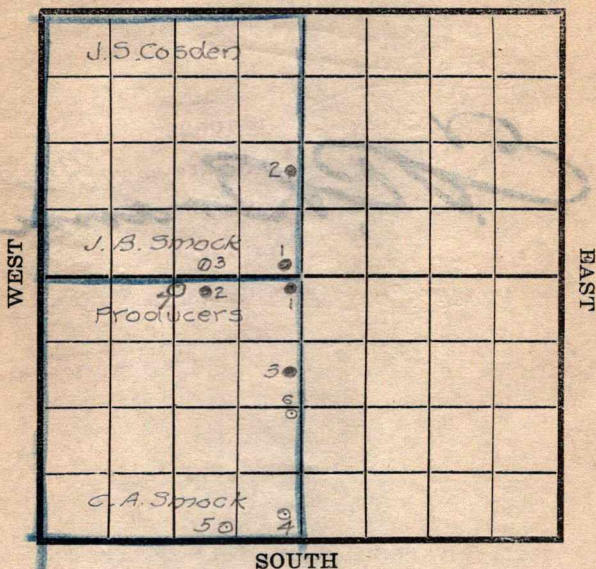

Location _____

Rig Up _____

Drilling and remarks _____

RECORD

Cased _____ in. _____ Ft.

Sand _____

Gas _____

Oil _____

Total Depth _____

PRODUCTION

1st 24 hrs. Nat. _____

1st 24 hrs. after shot _____

Gas _____ Cu. Ft.

Dry Hole _____

Abandoned _____


Date _____

_____, 191____ Scout _____

Our map shows as
on this ticket. Is
your Location correct?

C. P. Brown

RETURNED BY _____
 IN FRACING *R.M.*
 ON U.S. MAP _____
 ON FRANTZ MAP _____
 ON MOODY MAP _____
 FILED _____

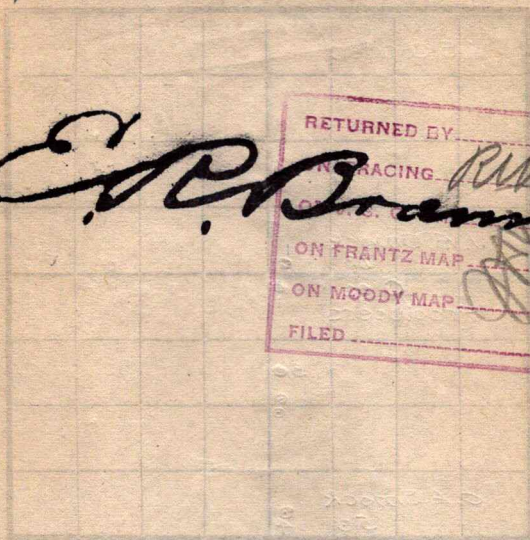

SOUTH

RECORD		LOCATION	
Gas	_____	Big Up	_____
Oil	_____	Drilling and remarks	_____
Total Depth	_____		
PRODUCTION			
Gas	_____		
Oil	_____		
Dry Hole	_____		
Abandoned	_____		

Date