


Map No. 4 Sec. 2 Twp. 27 R. 5
 Well No. 1 Haverhill Druck Farm
Haverhill Rex. Co. Company

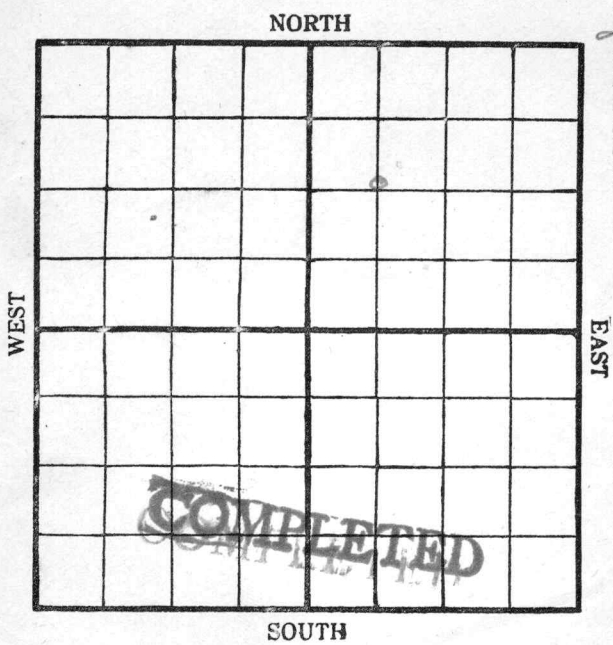

Location _____

Drilling Remarks:

RECORD

Cased _____ in. _____ ft.

Sand _____

Gas _____

Oil _____

Total Depth _____

Rig Up _____

Drilling Remarks:

PRODUCTION

1st 24 hrs. Nat. _____

1st 24 h.s. after shot _____

Gas _____ cu. ft

Dry Hole _____

Abandoned _____

Map No. K11 Sec. 2 Twp. 27 R. 5Well No. 7 FarmWorrell Company

NORTH

WEST



EAST

SOUTH

Location -----

Rig Up -----

Drilling and remarks

RECORD

Cased ----- in. ----- Ft.

Sand -----

Gas -----

Oil -----

Total Depth -----

PRODUCTION

1st 24 hrs. Nat. -----

1st 24 hrs. after shot -----

Gas ----- Cu. Ft.

Dry Hole -----

Abandoned -----


FIRST REPORT

Date

527, 1918 Candry Scout

Map No. _____ Sec. 2 Twp. 27 R. 5Well No. 7 SurrockStarobill CompanyPlutcher & Gore Eldredge Contractor

NORTH

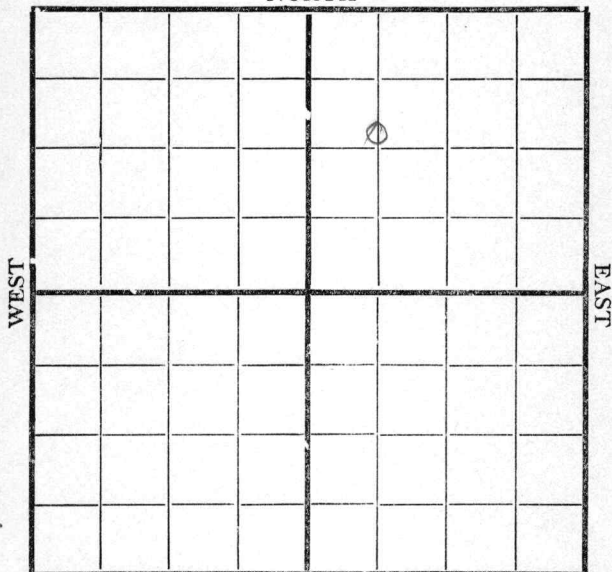

SOUTH

Location _____

Rig up _____

Drilling and Remarks:

250

RECORD

Cased _____ in., _____ ft.

Sand _____

Gas _____

Oil _____

Total Depth _____

PRODUCTION

1st 24 hrs. Nat. _____

1st 24 hrs. after shot _____

Gas _____ Cu. Ft.

Dry Hole _____

Abandoned _____

Date

6/19

191

P. Carls

Scout

Map No. _____ Sec. 2 Twp. 27 R. 5Well No. 7 SummitStearns Hill Company

Contractor _____

NORTH

WEST

EAST

SOUTH

Location _____

Rig up _____

Drilling and Remarks:

760

RECORD

Cased _____ in., _____ ft.

Sand _____

Gas _____

Oil _____

Total Depth _____

PRODUCTION

1st 24 hrs. Nat. _____

1st 24 hrs. after shot _____

Gas _____ Cu. Ft.

Dry Hole _____

Abandoned _____

Date

6/26 1918 Candley Scout

Map No. _____ Sec. 2 Twp. 27 R. 5Well No. 7 _____


_____ Company

_____ Contractor

NORTH

WEST

EAST

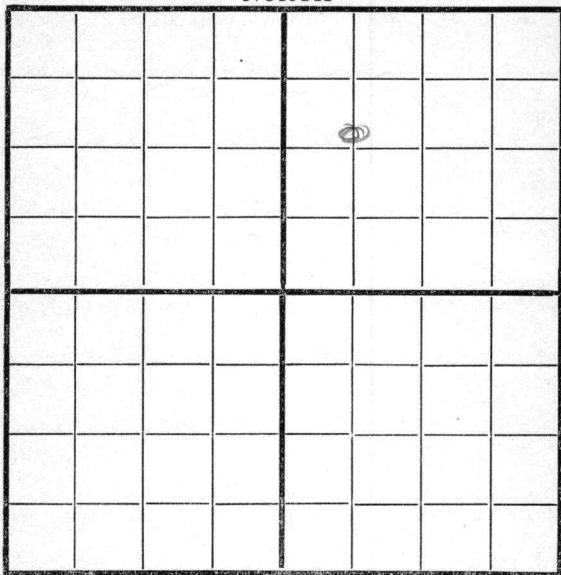

SOUTH

Location _____

Rig up _____

Drilling and Remarks:

1300

RECORD

Cased _____ in., _____ ft.

Sand _____

Gas _____

Oil _____

Total Depth _____

PRODUCTION

1st 24 hrs. Nat. _____

1st 24 hrs. after shot _____

Gas _____ Cu. Ft.

Dry Hole _____

Abandoned _____

Date

7/3


191

P. Conley

Scout

Map No. _____ Sec. 2 Twp. 27 R. 5Well No. 7 SurockHarcubille Company

Contractor _____

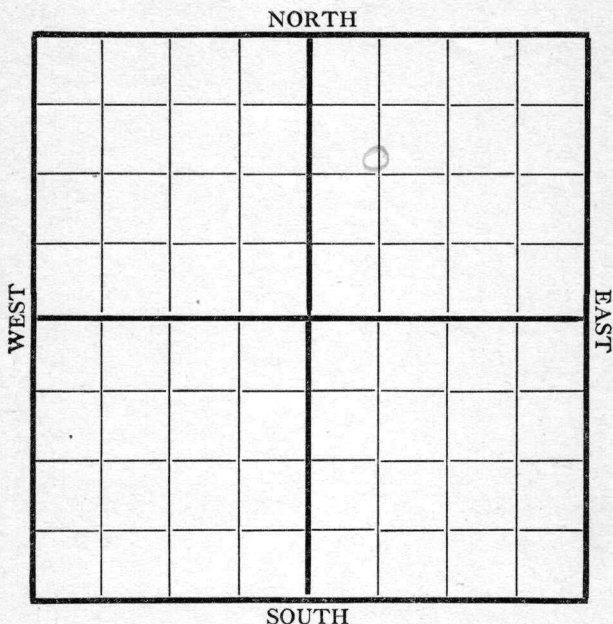**RECORD**

Location _____

Cased _____ in., _____ ft.

Rig up _____

Sand _____

Drilling and Remarks:

Gas _____

Oil _____

Total Depth _____

PRODUCTION

1st 24 hrs. Nat. _____

1st 24 hrs. after shot _____

Gas _____ Cu. Ft.

Dry Hole _____

Abandoned _____

Date

7/10

191

Planduff

Scout

Map No. _____ Sec. 2 Twp. 27 R. 5

Well No. 7 Smack


Storckhill Company

Contractor

NORTH

WEST

EAST

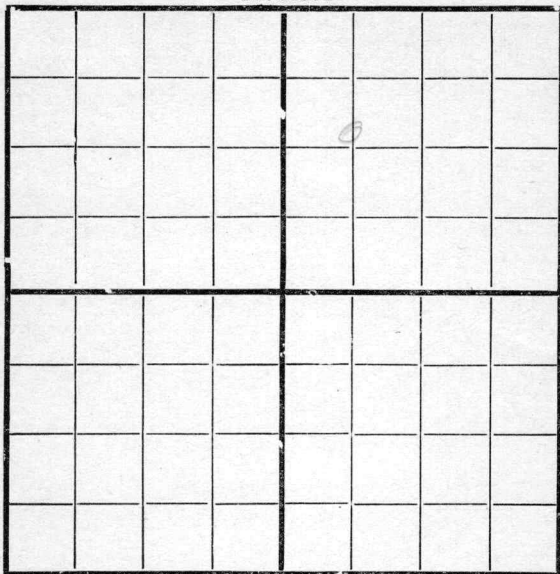

SOUTH

Location _____

Rig up _____

Drilling and Remarks:

1945

RECORD

Cased _____ in., _____ ft.

Sand _____

Gas _____

Oil _____

Total Depth _____

PRODUCTION

1st 24 hrs. Nat. _____

1st 24 hrs. after shot _____

Gas _____ Cu. Ft.

Dry Hole _____

Abandoned _____

Date

7/17

191

J. Carberry

Scout


Map No. _____ Sec. 2 Twp. 27 R. 5Well No. 7 _____Hoselink _____ Company

_____ Contractor

NORTH

WEST

EAST

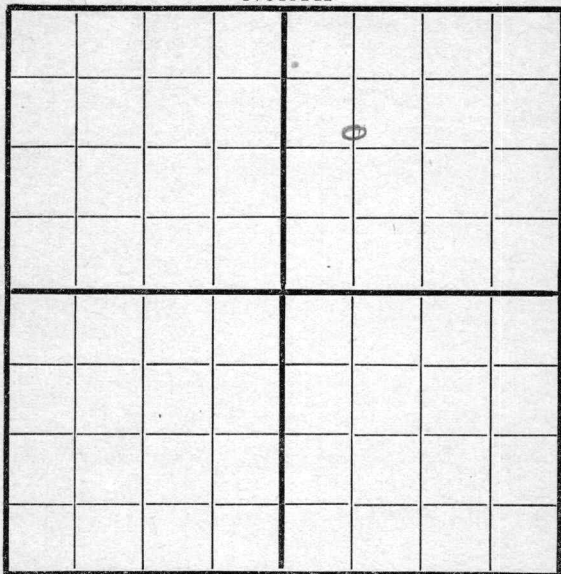

SOUTH

Location _____

Rig up _____

Drilling and Remarks:

2300

RECORD

Cased _____ in., _____ ft.

Sand _____

Gas _____

Oil _____

Total Depth _____

PRODUCTION

1st 24 hrs. Nat. _____

1st 24 hrs. after shot _____

Gas _____ Cu. Ft.

Dry Hole _____

Abandoned _____

Date


7/24 _____ 191 _____ Scout

Map No. _____ Sec. 2 Twp. 27 R. 5Well No. 7 SmokeHaverhill Petro Company

Contractor _____

NORTH

WEST

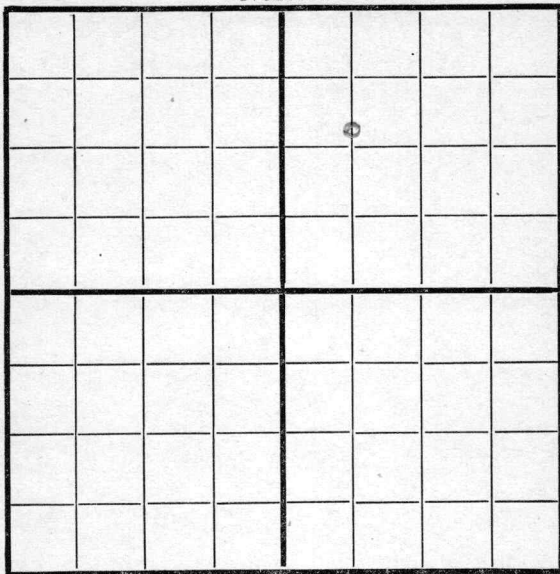

EAST

SOUTH

RECORD

Location _____

Cased _____ in., _____ ft.

Rig up _____

Sand _____

Drilling and Remarks:

Gas _____

Oil _____

Total Depth _____

2640

PRODUCTION

1st 24 hrs. Nat. _____

1st 24 hrs. after shot _____

Gas _____ Cu. Ft.


Dry Hole _____

Abandoned _____

Date

7/311918Cordery

Scout

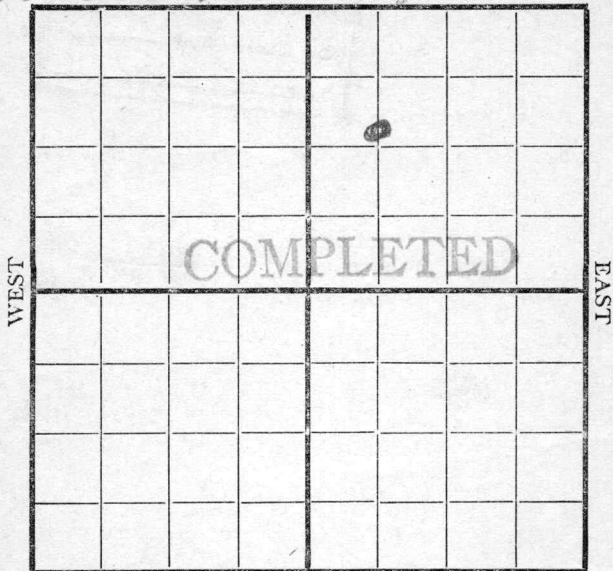Map No. K11 Sec. 2 Twp. 27 R. 5Well No. 7 SnookHarcill Petroleum CompanyPhinchant & Gore ContractorE. P. Drago NORTH Ko

SOUTH

Location _____

Rig up _____

Drilling and Remarks:

Est at
125
03 hrs

RECORD

Cased _____ in., _____ ft.

Sand 2705-2715

Gas _____

Oil _____

Total Depth _____

PRODUCTION

1st 24 hrs. Nat. _____

1st 24 hrs. after shot _____

Gas _____ Cu. Ft.

Dry Hole _____

Abandoned _____

Date

8/5 1918 A. Conroy Scout