

Map No. _____ Sec. 2 Twp. 27 R. 5
 Well No. 10 Smock Farm _____
Haverhill Company _____

NORTH

WEST

EAST

SOUTH

Location _____

Drilling Remarks:

RECORD

Cased _____ in. _____ ft.

Sand _____

Gas _____

Oil _____

Total Depth _____

Rig Up _____

Drilling Remarks:

PRODUCTION

1st 24 hrs. Nat. _____

1st 24 hrs. after shot _____

Gas _____ cu. ft.

Dry Hole _____

Abandoned _____

Map No. 511 Sec. 2 Twp. 27 R. 5

Well No. 10 Smock
Haverhill Petro Company

Company

Contractor

NORTH

WEST

EAST

SOUTH

Location _____

Rig up _____

Drilling and Remarks:

RECORD

Cased _____ in., _____ ft.

Sand _____

Gas _____

Oil _____

Total Depth.....

PRODUCTION

1st 24 hrs. Nat. _____

1st 24 hrs. after shot.....

Gas.....Cu. Ft.

Dry Hole_____

Abandoned.....

FIRST REPORT

Date _____

191


Scout

Map No. X11 Sec. 2 Twp. 27 R. 5Well No. 10 Snook
Honerhill Company

Contractor

NORTH

WEST

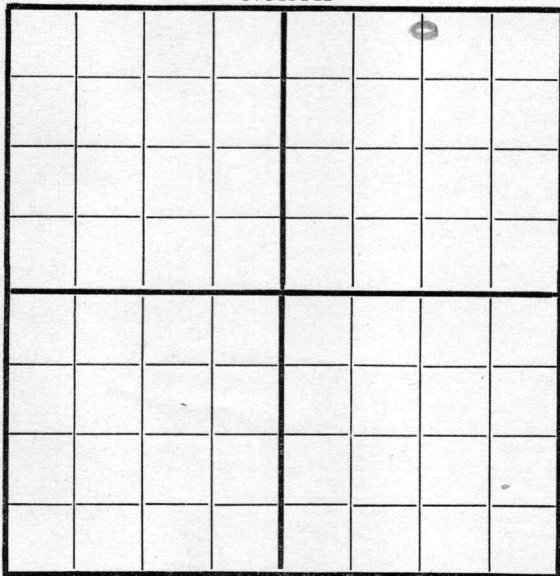

EAST

SOUTH

200 X 13 20 E

Location _____

Rig up _____

Drilling and Remarks:

Rigged
up

RECORD

Cased _____ in., _____ ft.

Sand _____

Gas _____

Oil _____

Total Depth _____

PRODUCTION

1st 24 hrs. Nat. _____

1st 24 hrs. after shot _____

Gas _____ Cu. Ft.

Dry Hole _____

Abandoned _____

Date

12/25 1918 Conroy Scout

Map No. 1511 Sec. 2 Twp. 27 R. 5Well No. 10Horsehide Company

Contractor

NORTH

WEST

EAST

SOUTH

Location _____

Rig up _____

Drilling and Remarks:

RECORD

Cased _____ in., _____ ft.

Sand _____

Gas _____

Oil _____

Total Depth _____

PRODUCTION

1st 24 hrs. Nat. _____

1st 24 hrs. after shot _____

Gas _____ Cu. Ft.

Dry Hole _____

Abandoned _____

Date

191

Scout


Map No. 1511 Sec. 2 Twp. 27 R. 5Well No. 10H. H. H. H. H. Company

Contractor

NORTH

WEST

EAST

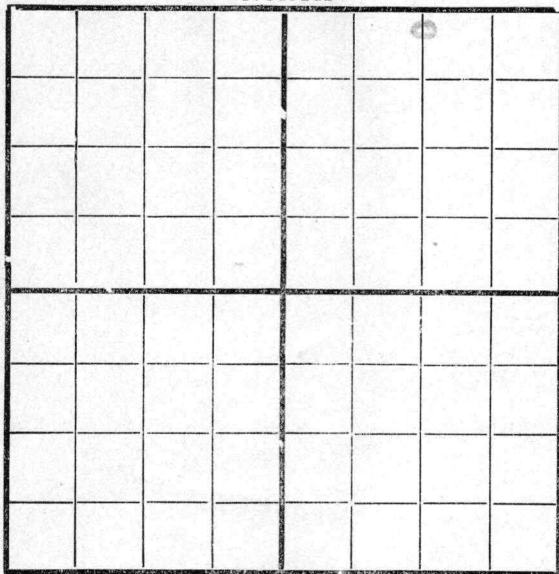

200 + 13 SOUTH

Location _____

Rig up _____

Drilling and Remarks:

*Rigged
up*

RECORD

Cased _____ in., _____ ft.

Sand _____

Gas _____

Oil _____

Total Depth _____

PRODUCTION

1st 24 hrs. Nat. _____

1st 24 hrs. after shot _____

Gas _____ Cu. Ft.


Dry Hole _____

Abandoned _____

Date

1/8 1918 C. H. C. H. C. Scout

Map No. 1511 Sec. 2 Twp. 27 R. 5
Well No. 10 Sumner
Sumner Company
Contractor

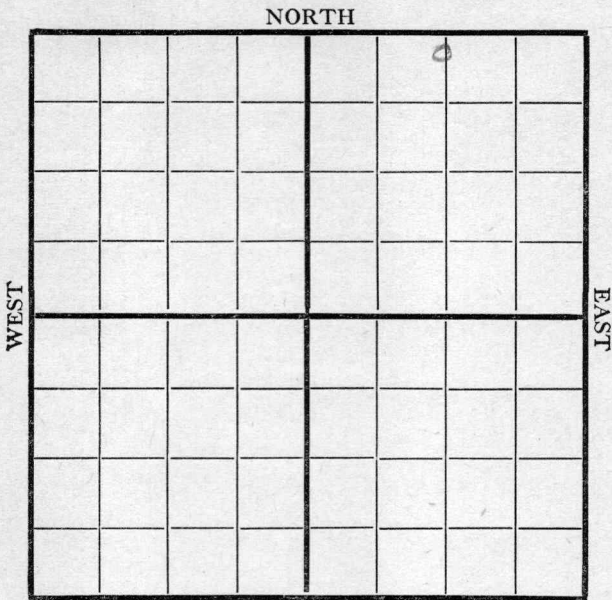

200 N 1320

Location _____
Rig up _____
Drilling and Remarks:

Rigged up

RECORD

Cased _____ in., _____ ft.
Sand _____
Gas _____
Oil _____
Total Depth _____

PRODUCTION

1st 24 hrs. Nat. _____
1st 24 hrs. after shot _____
Gas _____ Cu. Ft.
Dry Hole _____
Abandoned _____

Date 1/15 1919 Amery Scout

Map No. 1511 Sec. 2 Twp. 27 R. 5


Well No. 10 Sucker
Husculhill Company

Contractor

NORTH

WEST

EAST

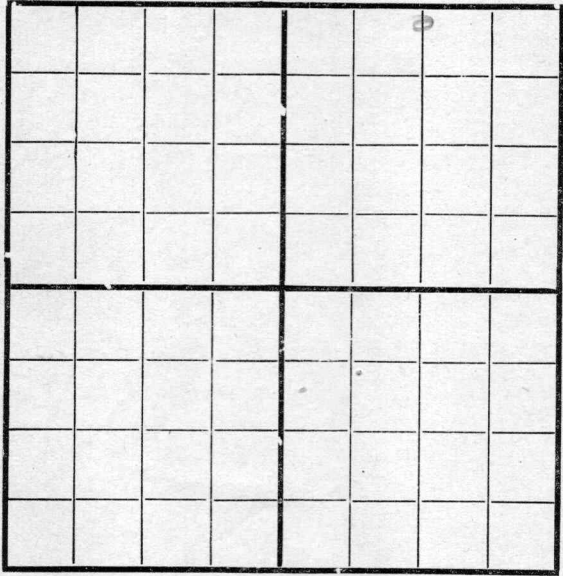

SOUTH

500 18 13200

Location

Rig up

Drilling and Remarks:

Rigged up

RECORD

Cased _____ in., _____ ft.

Sand _____

Gas _____

Oil _____

Total Depth _____

PRODUCTION

1st 24 hrs. Nat. _____

1st 24 hrs. after shot _____

Gas _____ Cu. Ft.

Dry Hole _____

Abandoned _____

Date

1/22 1919 C. C. C. Scout


Map No. K 11 Sec. 2 Twp. 27 R. 5Well No. 10 SmockHaverhill Oil Company

Contractor

NORTH

WEST

EAST

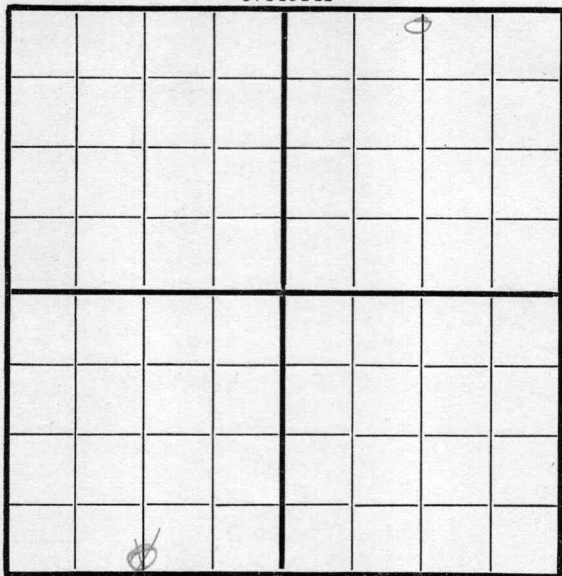

SOUTH

RECORD

Location _____

Cased _____ in., _____ ft.

Rig up _____

Sand _____

Drilling and Remarks:

Gas _____

Oil _____

Total Depth _____

PRODUCTION

1st 24 hrs. Nat. _____

1st 24 hrs. after shot _____

Gas _____ Cu. Ft.

Dry Hole _____

Abandoned _____

Date

3/8191 9

Pyle

Scout


Map No. K 11 Sec. 2 Twp. 27 R. 5Well No. 10 Smoke
Haverhill Pet- Company

Contractor

NORTH

WEST

EAST

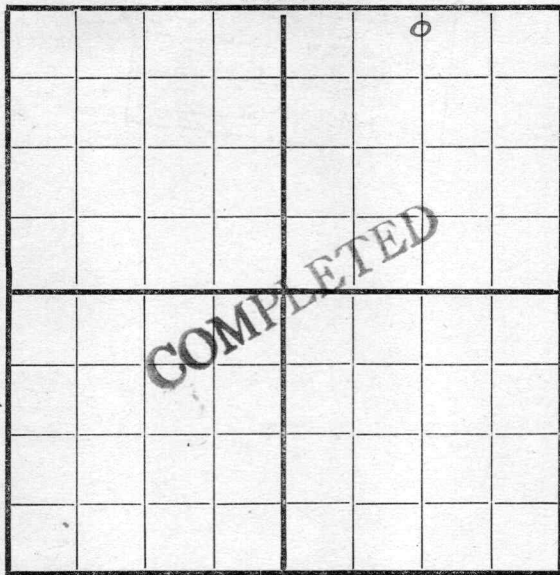

200 N

SOUTH

1320 E

Location _____

Rig up _____

Drilling and Remarks:

RECORD

Cased _____ in. _____ ft.

Sand 2670 - 2686

Gas _____

Oil _____

Total Depth _____

PRODUCTION

1st 24 hrs. Nat. 40 bbb

1st 24 hrs. after shot _____

Gas _____ Cu. Ft.

Dry Hole _____

Abandoned _____

Date

4/24191 9

Pyle

Scout