


Map No. K-11 Sec. 2 Twp. 27 R. 5  
 Well No. 11 Smock Farm  
Haverhill Dist. Company

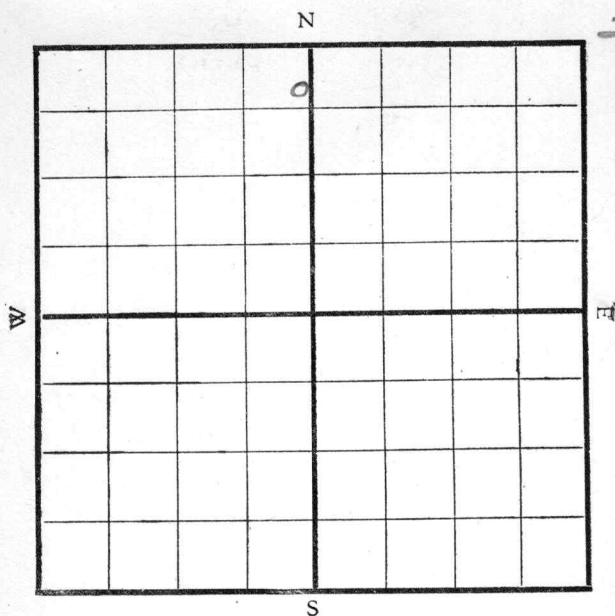

Location -----

Drilling Remarks:

-----

-----

-----

-----

-----

-----

-----

-----

-----

-----

## RECORD

Cased ----- in. ----- ft.

Sand -----

Gas -----

Oil -----

Total Depth -----

Rig Up -----

Drilling Remarks:

-----

-----

-----

-----

-----

-----

-----

-----

-----

-----

## PRODUCTION

1st 24 hrs. Nat. -----

1st 24 hrs. after shot -----

Gas ----- cu. ft.

Dry Hole -----

Abandoned -----

Map No. K 11 Sec. 2 Twp. 27 R. 5Well No. 11 SmockKoverhill Gas Company

Contractor

## SECTION PLAT

460 Ft. from N. Line

Ft. from S. Line

200 Ft. from E. Line

Ft. from W. Line

|  |  |  |  |
|--|--|--|--|
|  |  |  |  |
|  |  |  |  |
|  |  |  |  |
|  |  |  |  |

Location

Rig up

Drilling and Remarks:

## RECORD

Cased \_\_\_\_\_ in., \_\_\_\_\_ ft.

Sand \_\_\_\_\_

Gas \_\_\_\_\_

Oil \_\_\_\_\_

Total Depth \_\_\_\_\_

## PRODUCTION

1st 24 hrs. Nat. \_\_\_\_\_

1st 24 hrs. after shot \_\_\_\_\_

Gas \_\_\_\_\_ Cu. Ft.

Dry Hole \_\_\_\_\_

Abandoned \_\_\_\_\_

Date

9/28 1919

Scout

Pyle