KANSAS

EDWARDS

T. 23 R. 20W

7

11-64

FERGUSON COMPANY

LIPPOLDT NO. 1

COMMENCED C SW NE

COMPLETED

REMARKS TD 4660'

ELEVATION 2302KB

PRODUCTION D&A

E. Log.

Kraftbilt 187 ROSS-MARTIN CO.
TULSA 1, OKLAHOMA PRINTED IN U.S.A.

DSt #1: 4550-4660,
op 1hr, WB/incr,
R 260'M, 270'MW,
NSO, ISIP 1479#/30",
FP's 87-342#,
FSIP 1444#/30".

100

200

300

400

500

600

700

800

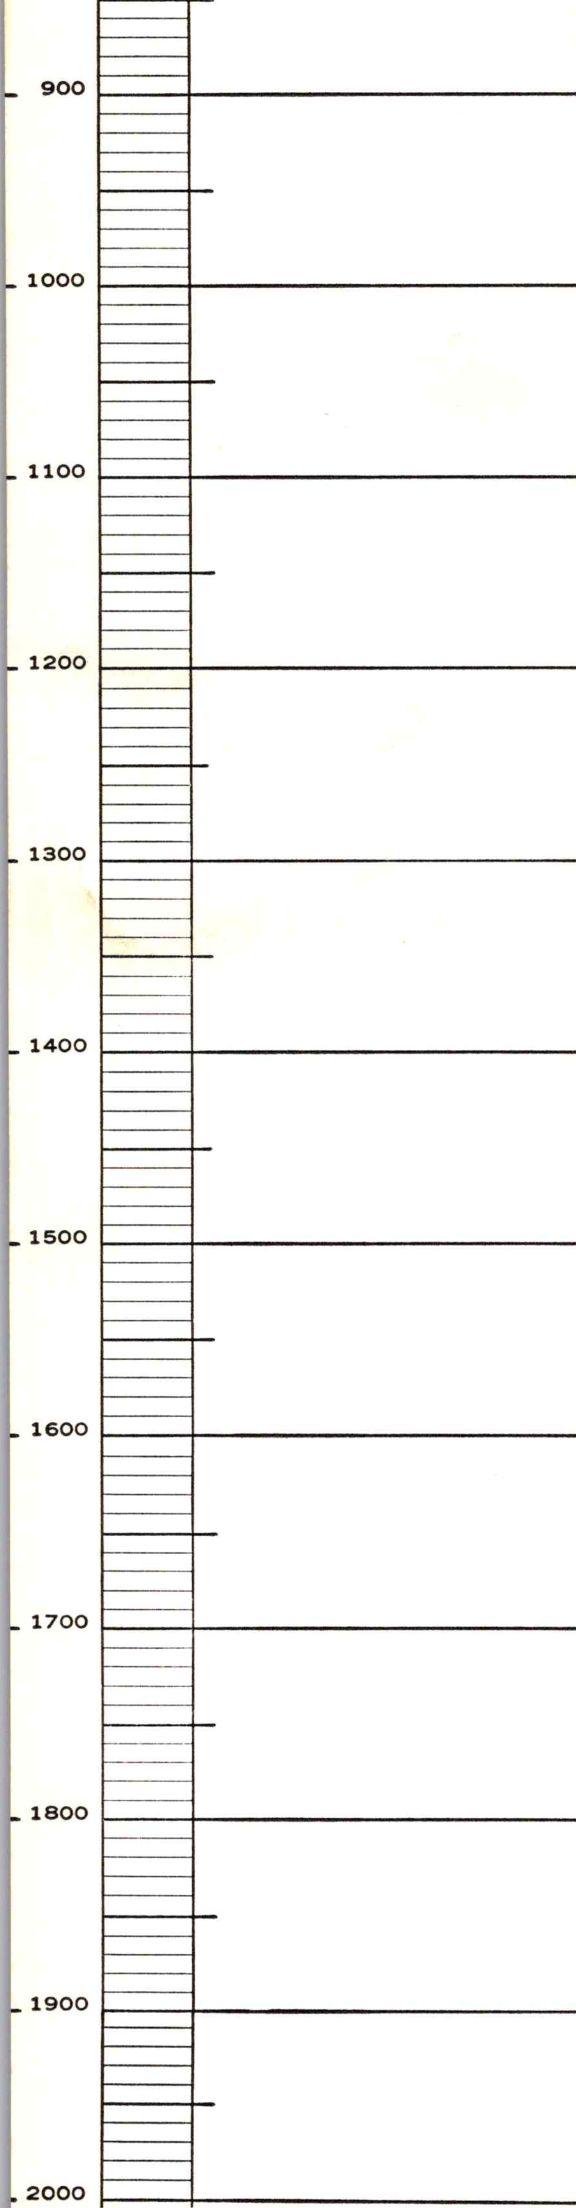

2100

2200

2300

2400

2500

2600

2700

2800

2900

3000

3100

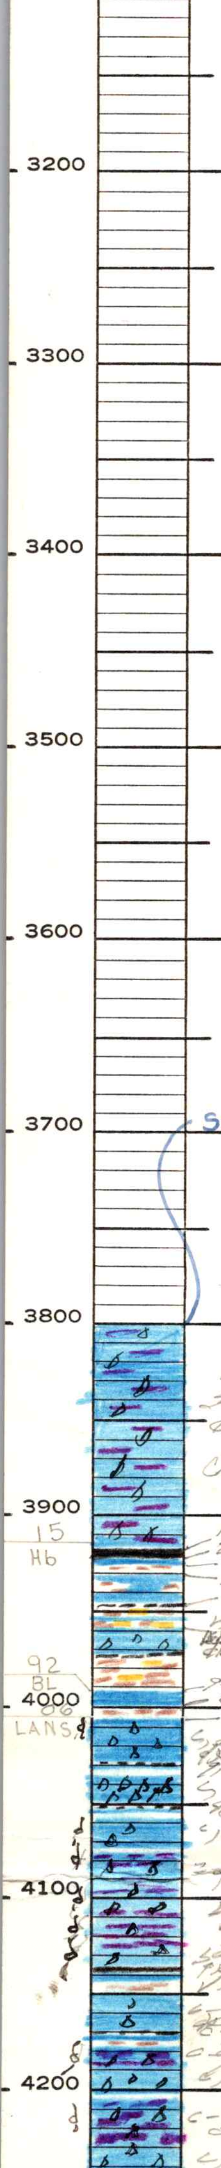

SAMPLES START@ 3800'

[illegible]

Wh to bf, svc to f xln soft [illegible] [illegible] dy [illegible] [illegible]

chalky streaks in pt

Hbnr Sh 3917

17 [illegible] Sh
22 [illegible]
25 V col Sh [illegible]
30 [illegible]
40 [illegible] Sh
[illegible]
92 [illegible]
00 [illegible]
06 [illegible]

Brown Lst 3992

[illegible] dy [illegible]

Ls 4006

[illegible] Sh
V col Sh [illegible] sl dy
[illegible]
[illegible] dy [illegible]
[illegible] dy

c- bf, svc to f xln dy [illegible]
[illegible]
[illegible] dy

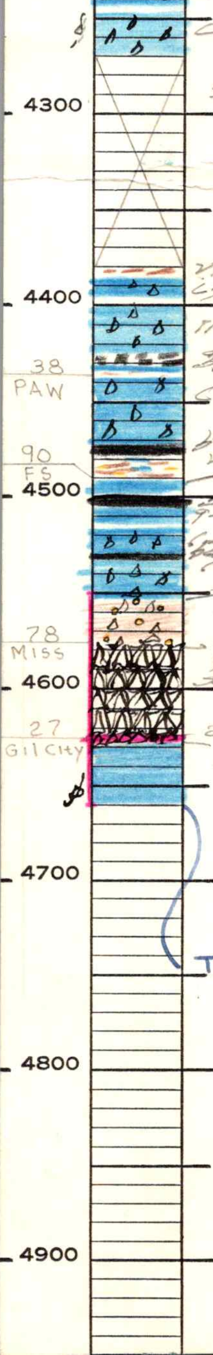

c, d+ dy. ool [illegible] osc [illegible] pt

skip

[illegible] sh
[illegible] dy

[illegible] sh
[illegible]

[illegible] dy

PBG 4552

[illegible] sh [illegible] silty sh

[illegible]

[illegible] dy

Miss 4578

[illegible] osc dy

v.c.d. sl in vg. sdy, clay + sh.

78 wh to cream flaky opq [illegible] fos. [illegible]

22 g f xln dy [illegible]
28 wh + g. fos. ool mpt

TOTAL DEPTH 4660'

37
36