


5-75

STATE <i>Kansas</i>		COMPANY <i>Sutton</i>	
COUNTY <i>Hodgeman</i>	FARM <i>Cook</i>	WELL NO. <i>1</i>	
BLOCK		SURVEY	
SEC. <i>30</i>		TOTAL DEPTH <i>4681</i>	
T. <i>23S</i>	R. <i>22W</i>		
		<i>E-Sw-NE</i>	
		COMMENCED	
		COMPLETED	
		REMARKS	
ALTITUDE <i>2375</i>		<i>70 Elog</i>	
PRODUCTION <i>O. & H.</i>			

CASING RECORD

SHOT	QUARTS	BETWEEN
------	--------	---------

FORM 186 - In stock and for sale by Ross-Martin Co., Tulsa

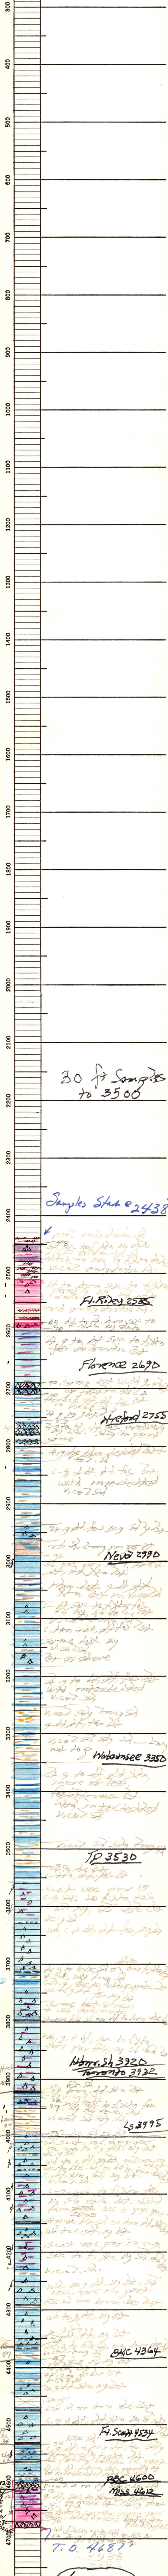

670