


Section 12 Township 18 Range 11WWell No. #2 HarperCompany Harms-Burt Drlg.

NORTH

WEST

EAST

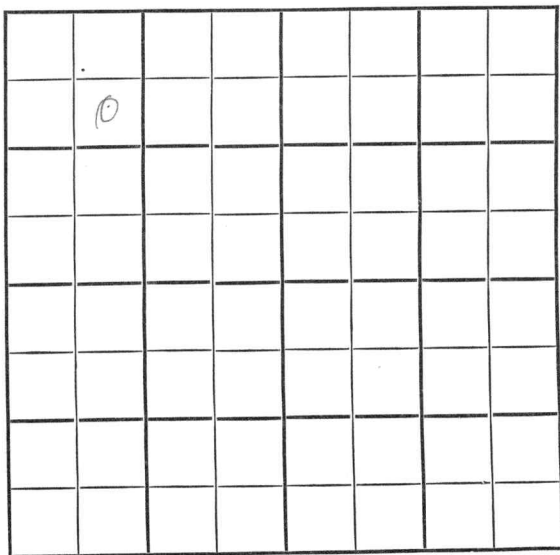

SOUTH

County Barton Elev. _____
 Sec. 12 Twp. 18 Rge. 14W
 Company Harms-Burt Drlg.
 Farm Name Harper No. 2

TOPS	DEPTH	LOG	DATUM	Loc. in Sec.
Anh.				SE NW NW
TP.				
H.				
Tr.				
Dg.				
BL.				
L.				Geol.
K.C.				Contr.
B.K.C.				Co. tools
Ce.				Pool
C.				Boyd
M.				
M.				
K.				
Mz.				
Ma.				
V.				
S.				
S.				
A.				
R.				
Pe.				
G.				
T.D.				

FIRST REPORT
 JAN 9 '57

Date Comm.

M I R

130

Co.

L. Sec.

No.

Sec.

T.

R.

County Barton Elev. 1858
 Sec. 12 Twp. 18 Rge. 14W
 Company Harms-Burt Drlg.
 Farm Name Harper No. 2

TOPS	DEPTH	LOG	DATUM	Loc. in Sec.
Anh.				SE NW NW
Tr.				
Dg.				
Bl.	3095			
L.	3107			
K.C.				Geol.
B.K.C.				Contr.
Ce.				Co. tools
C.	3308			Pool
M.				Boyd
M.				
K.				
Mz.				
Mq.				
V.				
S.				
S.				
A.	3329			
R.				
PE.				
G.				
TD.	3334			

0	FEB 13 1957
COMPLETE	

Date Comm.

M I R 1-10-57 878.795

3040 JAN 23 57 DST 3329-34
 1hr rec 30' oil + 30' mdg oil
 + 30' oily md BHP 840
 5 1/2 @ 3331 / JAN 30 57 CO 3334 \$
 1 Boph DD @ 3338 FEB 6 57 DD
 3343 TD No inc PB 3335
 1 1/2 \$ 1 1/4 Boph 1 \$ 2 1/2 Boph
 no/w 4 hrs POP FEB 13 57 P. 25 Boph
 no/w tr.