


Section 9 Township 18 Range 14W

Well No. #1 Logan

Company Republic Natural Gas

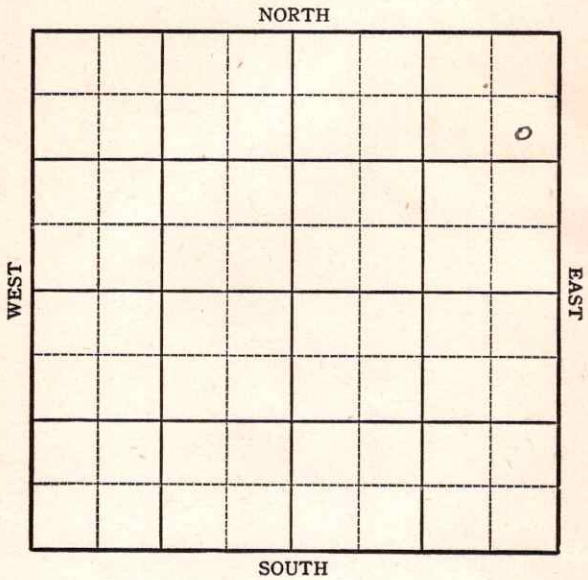

KANSAS

Barton


Sec. 9 Twp. 18 R. 14WWell No. #1 Logan FarmRepublic Natural Gas Company

Boyd

990 Ft. from N. Line Ft. from S. Line330 Ft. from E. Line Ft. from W. Line

SE NE NE

elev. 1933

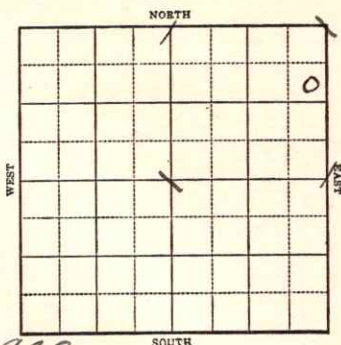

1944

R E P O R T

2/9 Location

2/15 Rotary

2/23 15" @ 108

Anhy 878

Drlg. 923

3/1 Drlg. 2000'

3/8 Lans 3160 St 3172-75

Drlg. 3254'

3/16 Arb. 3401-08 TD

7" @ 3402

Swb 20 oil per hr

3/22 TD 3412

500 acid swb 93 oil in 4 hrs.

3/29 " " "

4/5 " " "

4/12 " " "

4/19 " " "

OVER

1944

4/26 TD 3412 500 acid swb & 93 oil in
4 hrs.

5/3 " "

5/10 " 2"

5/17 " "

5/24 7" @ 3402

Arb 3401

TD 3412

2000 acid

Pump 601 Pot

Gravity 37

COMPLETED

KANSAS


Map No. 73 Sec. 9 Twp. 18 R. 14WWell No. 1 LoganRepublic Natural Gas Company

FIRST REPORT

Contractor

SE NE NE

SECTION PLAT

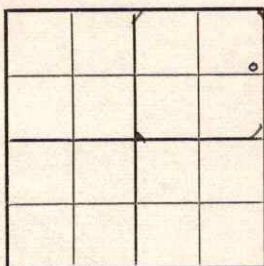990 Ft. from N. Line Ft. from S. Line330 Ft. from E. Line Ft. from W. Line

Boyd Pool

Location XRig up

Drilling and Remarks:

RECORD

Cased in., ft.Sand Gas Oil Total Depth

PRODUCTION

1st 24 hrs. Nat. 1st 24 hrs. after shot Gas Cu. Ft.Dry Hole Abandoned

Date

FEB 9 1944 19S. J. LEWIS Scout

Pool Name Boyd Pool**KANSAS**Map No. 73 Sec. 9 Twp. 18 R. 14WWell No. 1 LoganRepublic Natural Gas CompanyCOMPLETED Contractor
SE NE NE

SECTION PLAT

990 Ft. from N. Line Ft. from S. Line330 Ft. from E. Line Ft. from W. Line

			o

Barton CountyLocation Rig up

Drilling and Remarks:

*Ac 83401**7" @ 3402**2000 acid**Pump 601 Pst**37° Gr*

RECORD

Cased in., ft.Sand Gas Oil Total Depth 3412

PRODUCTION

1st 24 hrs. Nat. 1st 24 hrs. after shot Gas Cu. Ft.Dry Hole Abandoned

Date

MAY 24 1940 19S. J. LEWIS Scout