


Russell County
 Delvald Farm No. 1
 Eldorado Refg. Co.
 Sec. _____ Twp. _____
 NE 1/4 NW
 Elev. _____ T.D. 3045
 Date Drilled 9/20/41
 Correlation by _____
 Pro - Pot 206.55 B

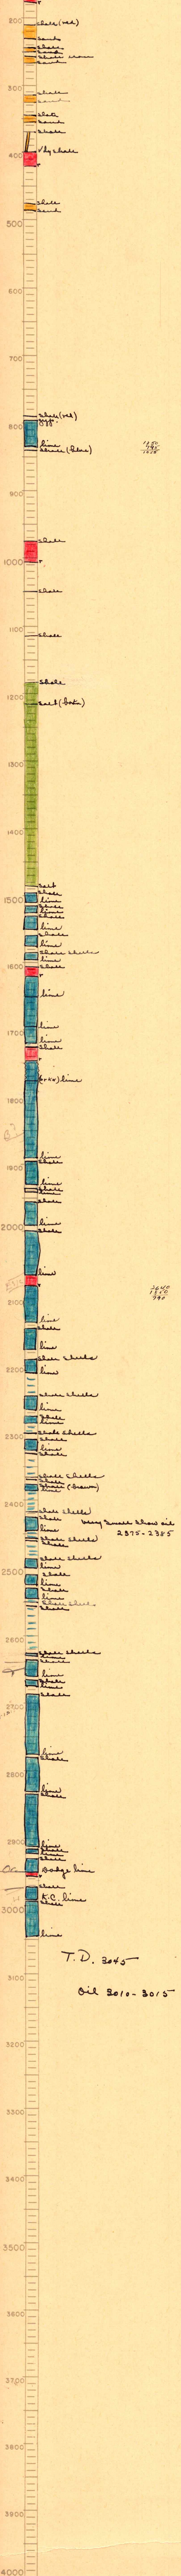

1550
 795
 1055

2640
 1850
 790

