

STAFFORD.

County

CLEO JOHNSON, No. 10.


Farm

E. H. MOORE, INC.

Company

Sec.

Twp.

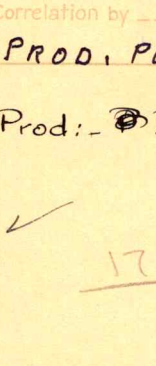

6	5	4	3	2	1
7	8	9	10	11	12
13	14	15	16	17	18
19	20	21	22	23	24
25	26	27	28	29	30
31	32	33	34	35	36

SW NE SE

Elev. TD. 3814'

Date Drilled 1-23-19.

Correlation by

PROD. POT. 46 B.

18WPH

Prod: - Disposal well after deepening.

1766

SHALE, SHELLS, SALT.

K. C.

X CORED TOP MISENER 3799'
1/4" CHERT. CORED 3805'
WFr. TD. 3814', TOP VIOLA 3810'

Deepening Record-
10-16-39
Disposal Well

sh. green

iron

Arbuckle
SLM-4055-4048

T.D. 4273'