FORM 51 5M BRIX


KANSAS

Coffey County

Section 14 Township 23 Range 13E

Well No. #9 Joe Bahr

Company Mid-Continent Pet.

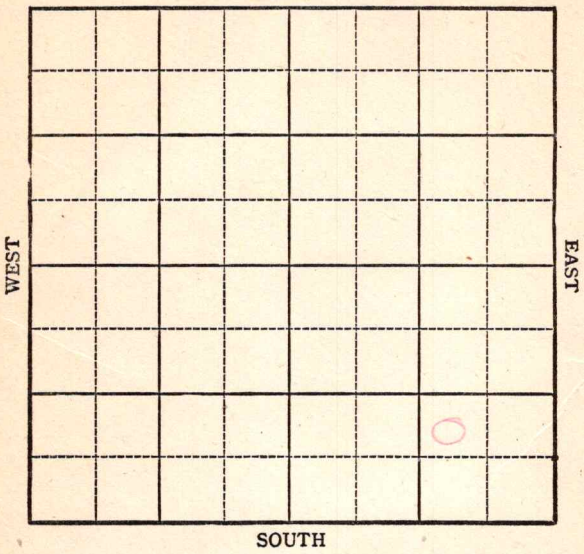

E1 -

FORM 252-A
5M 9-44 PETROL

KANSAS Coffey County

Sec. 14 Twp. 23 R. 13E

Well No. #9 Joe Bahr Farm

Mid-Continenta Pet. Company

Virgil


____ Ft. from N. Line

990 Ft. from S. Line

990 Ft. from E. Line

____ Ft. from W. Line

NW SE SE

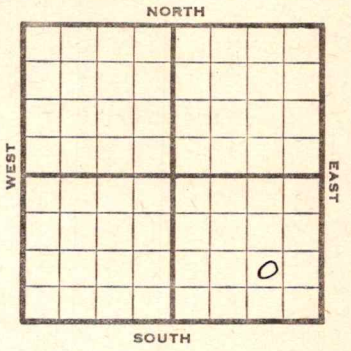

1944	REPORT
10/18	8" @ 60' WOC
10/25	Chat 1726 - 29 TD 5" @ 1728 RUST
11/1	" " " " " "
11/8	TD 1762 2000 acid
11/15	Chat 1726 5" @ 1728' 2000 acid TD 1762 Pump 40 Pot. Grav. 38.0

COMPLETED

FORM 26 200 BKS 2-44 PETROL

KANSAS

Pool Name Virgil

Map No. 17 Sec. 14 Twp. 23 R. 13E

Well No. 9 Joe Bahr


Mid-Continent Pet. Company

FIRST REPORT

Contractor

NW SE SE

SECTION PLAT

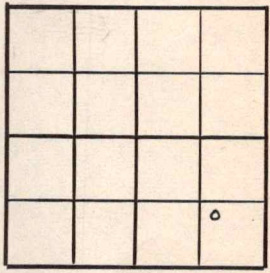

Ft. from N. Line

990 Ft. from S. Line

990 Ft. from E. Line

Ft. from W. Line

Coffey

Location

Rig up

Drilling and Remarks:

8"-60' WOC

RECORD

Cased in., ft.

Sand

Gas

Oil

Total Depth

PRODUCTION

1st 24 hrs. Nat.

1st 24 hrs. after shot

Gas Cu. Ft.

Dry Hole

Abandoned

Date

OCT 1 8 1944

19 S. J. LEWIS Scout

FORM 26 200 BKS 1-44 PETROL

Pool Name Virgil

Map No. 17 Sec. 14 Twp. 23 R. 13E


Well No. 9 Joe Bahr

Mid-Continent Pet. Company

COMPLETED Contractor

NW SE SE

SECTION PLAT

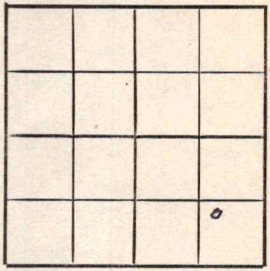

____ Ft. from N. Line

990 Ft. from S. Line

990 Ft. from E. Line

____ Ft. from W. Line

Coffey

Location

Rig up

Drilling and Remarks:

Okla 1726

5' @ 1728.

2000 acid

Pump 40 B.P.

38° Gr

RECORD

Cased ____ in., ____ ft.

Sand

Gas

Oil

Total Depth 1762

PRODUCTION

1st 24 hrs. Nat.

1st 24 hrs. after shot

Gas ____ Cu. Ft.

Dry Hole

Abandoned

Date

NOV 15 1944 19 S. J. LEWIS Scout