


STATE Kansas		COMPANY Sinclair-Prairie	
COUNTY Reno		FARM Seedle	
T. 24S R. 4W		WELL NO #2	
SURVEY 17		DIVISION	
		DISTRICT	
		KIND OF RIG	
		COMMENCED 3-15-36	
		COMPLETED 4-12-36	
		REMARKS SWC NE	
		330' fr S & 330'	
ELEV. 1470'		fr WL	
PRODUCTION INITIAL 338 B		SETTLED	

CASING AND SCREEN RECORD

16"-----530'	
8 1/4"-----3295'	

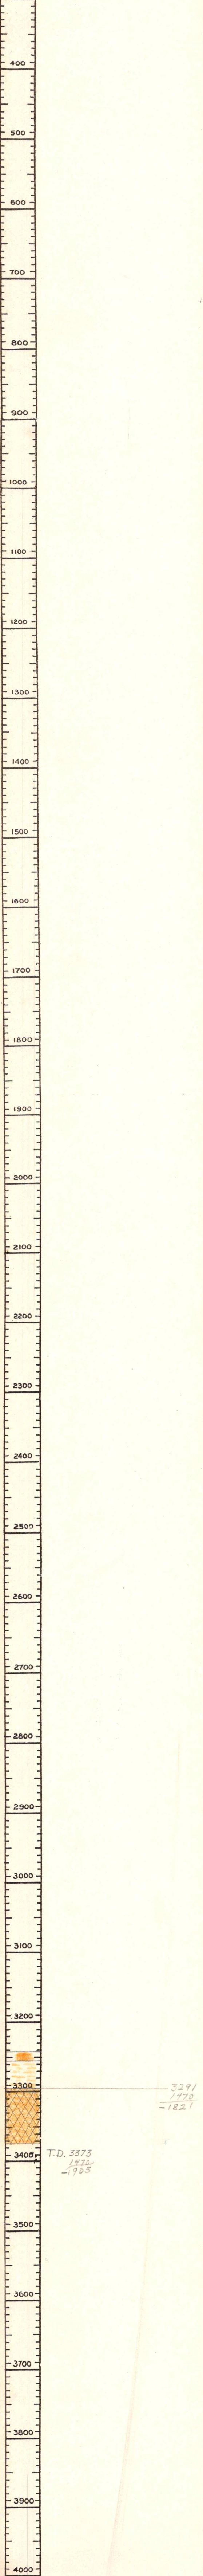

3291
1470
-1821

T.D. 3373
1470
-1903